

# SURVEY & REMONUMENTATION

MAR 21 1997

**LAND CORNER RECORDATION CERTIFICATE**  
Filing Requirement of Act 74, Mich. P.A. 1970

KALKASKA COUNTY, MICHIGAN  
RECEIVED

97 JAN 31 PM 3:19

For corners in **COMMISSION**

*Joan Hall*  
REG. DEEDS

<u>KALKASKA</u> <small>(County)</small>	Located In:	Corner Code: <u>##</u>
1996 REMONUMENTATION		
1. Public Land Survey	T <u>26N</u> R <u>7W</u>	<u>C-4</u>
	T _____ R _____	_____
	T _____ R _____	_____
	T _____ R _____	_____
2. Property Controlling in Section	S _____ T _____ R _____	_____
	S _____ T _____ R _____	_____
3. Miscellaneous Property in Sec.	S _____ T _____ R _____	_____
	S _____ T _____ R _____	_____

Register of Deeds Stamp & File Number

4. Lot No. \_\_\_\_\_, Recorded Plat \_\_\_\_\_  
5. Private Claims \_\_\_\_\_

	A	B	C	D	E	F	G	H	I	J	K	L
2	6		5		4		3		2		1	
3												
4	7	●	8		9		10		11		12	
5												
6	18		17		16		15		14		13	
7												
8	19		20		21		22		23		24	
9												
10	30		29		28		27		26		25	
11												
12	31		32		33		34		35		36	

I, EUGENE FARRIER, in a field survey on Nov. 21, 1996, do hereby certify that under requirements of P.A. 74, Michigan P.A. of 1970, the corner points mentioned in lines 1 and 2 above were in conformance with regulations and rules therefore as required in the current manual of survey instructions of the United States Department of the Interior, Bureau of Land Management or by a decree of a Court of Law and/or that the corner points mentioned in lines 3, 4 and 5 above were in conformance with the rules of the Michigan Board of Land Surveyors or by a Decree of a Court of Law; established, re-established, monumented, re-monumented, recovered, found as expressed below:

**NOTE: Not more than 4 corners, all in the same town and range, may be recorded on this certificate.**

**A. Description of original monument and accessories and/or subsequent restoration:**

C-04: Cor. common to Sec. 7 & 8, T26N-R7W, Orange Township 1849, GLO resurvey, set Cedar post. 9" Cedar, N71E, 9, 7" B. Ash, S51W, 7. Feb 28, 1885, E. Mosher, Co. Surveyor, used cor. no accessories. Sep 13, 1890, E. Mosher, Co. Surveyor, used cor. no accessories. March 1947, G.A. Shadko, fd. old stake believe to be original G.L.O cor. set standard monument. No accessories. 10/20/1967, revised G.A. Shadko survey by Uno A. Suomela 08-01-1991, E.D. Farrier, Survey #11291, fd. used cor. w/ accessories.

**B. Description of corner evidence found and/or method applied in restoring or reestablishing corner:**


C-04: Cor. common to Sec. 7 & 8, T26N-R7W, Orange Township Found DNR Mon w/ 4" x 4" Cedar Post. Left in place. No G.L.O. witnesses found. The Kalkaska Co. peer group approved & accepted the above monument as a careful and faithful perpetuation of the position of the original corner.

**Ratified by Peer Group**  
**P.A. 345 - 1990 Kalkaska County**

**Chairman** *Eugene Farrier*  
**Date** 1-21-97

**C. Description of monument for corner and accessories established to perpetuate localing the position of the corner:**

C-04: Cor. common to Sec. 7 & 8, T26N-R7W, Orange Township Found DNR Mon w/ 4" x 4" Cedar Post w/ accessories. Left D.N.R Monument in place.  
Found nail S75W 12" Cedar, 10.28'  
Found nail N45E 7" Cedar, 8.31'  
Found nail N85E 10" Cedar, 10.42'  
Found nail S45E 6" Ash, 5.64'  
N50W Centerline Over Head Power Line(N40E), 57.00'

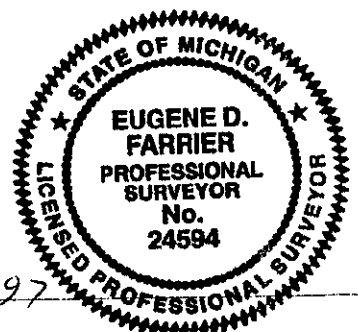

Signed by *Eugene Farrier*  
Surveyor's Michigan License No. 24594

Date 1-30-97