

# SURVEY & REMONUMENTATION

FEB 13 1998

## LAND CORNER RECORDATION CERTIFICATE Filing Requirement of Act 74, Mich. P.A. 1970

For corners in SECTION

<u>KALKASKA</u>	Located In:	Corner Code #
(County)		
1997 REMONUMENTATION		
1. Public Land Survey	T. <u>26N</u> R. <u>7W</u>	<u>C-8</u>
	T. _____ R. _____	_____
	T. _____ R. _____	_____
	T. _____ R. _____	_____
2. Property Controlling in Section	S. _____ T. _____ R. _____	_____
	S. _____ T. _____ R. _____	_____
3. Miscellaneous Property in Sec.	S. _____ T. _____ R. _____	_____
	S. _____ T. _____ R. _____	_____

Register of Deeds Stamp & File Number

4. Lot No. \_\_\_\_\_, Recorded Plat \_\_\_\_\_

5. Private Claims \_\_\_\_\_

	A	B	C	D	E	F	G	H	I	J	K	L	M
1													
2	6		5		4		3		2		1		
3													
4	7		8		9		10		11		12		
5													
6	18		17		16		15		14		13		
7													
8	19		20		21		22		23		24		
9													
10	30		29		28		27		26		25		
11													
12	31		32		33		34		35		36		
13													

I, EUGENE FARRIER, in a field survey on OCTOBER 28, 1997 do hereby state that under requirements of P.A. 74, Michigan P.A. of 1970, the corner points mentioned in lines 1 and 2 above were in conformance with regulations and rules therefore as required in the current manual of survey instructions of the United States Department of the Interior, Bureau of Land Management or by a decree of a Court of Law and for that the corner points mentioned in lines 3, 4 and 5 above were in conformance with the rules of the Michigan Board of Land Surveyors or by a Decree of a Court of Law; established, re-established, monumented, recovered, found as expressed below:


**NOTE:** Not more than 2 corners, all in the same town and range, may be recorded on this certificate.

A. Description of original monument and accessories and/or subsequent restoration:  
**C-8:** 1/4 Cor. Common to Sec. 19 & 20, T26N-R7W, Orange Township  
 1849, GLO resurvey, set Beech post, 11" Sugar N88E, 29, 13" Sugar N62W, 20  
 1902, W.S. Merrill Co. Surveyor, set stone (old cor.) From stake 33' East, no accessories  
 07-09-1982, Farrier Surveying, Cert. Survey, set 1/2" iron M.P.O.L. w/accessories, Lib 2, Pg. 813  
 03-29-1990, Farrier Surveying, LCR, set 1/2" iron S.P.M., Lib. 2, Pg. 402  
 11-14-1991, Farrier Surveying, Cert. Survey, fd. 1/2" iron M.P.O.L., w/accessories

B. Description of corner evidence found and/or method applied in restoring or reestablishing corner:  
**C-8:** 1/4 Cor. Common to Sec. 19 & 20, T26N-R7W, Orange Township  
 Fd. 1/2" x 18" rebar #24594. Pulled & replaced with 5/8" x 18" rebar w/brass cap in mon. Box 0.5' east of C/L Ryckman Road. No GLO witnesses were fd. The Kalkaska Co. Peer group approved & accepted the above monument as a careful and faithful reestablishment of the position of the original corner.

C. Description of monument for corner and accessories established to perpetuate locating the position of the corner:  
**C-8:** 1/4 Cor. Common to Sec. 19 & 20, T26N-R7W, Orange Township  
 Fd. 1/2" x 18" rebar #24594. Pulled & replaced with 5/8" x 18" rebar w/brass cap in mon. Box.  
 Set nail & tag, N31E 14" W. Pine, 97.40'  
 Set nail & tag, N44E 10" W. Pine, 67.04'  
 Fd. Spike, N76E 12" W. Pine, 46.08'  
 S68W steel fence post 76.44'

Ratified by Peer Group  
 P.A. 345 - 1990 Kalkaska County  
 Chairman Eugene Farrier  
 Date 1-29-98

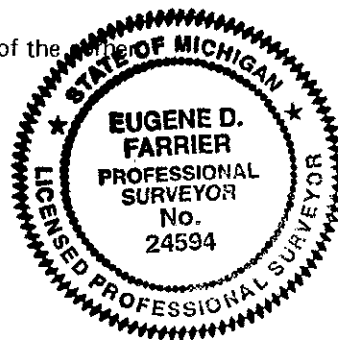

Signed by Eugene Farrier  
 Surveyor's Michigan License No. 24594

Date 2-3-98



3004827  
 Page: 1 of 1  
 02/04/98 11:22A  
 LB: 5 PG: 231