

# SURVEY & REMONUMENTATION

FEB 13 1998

## SECTION

### LAND CORNER RECORDATION CERTIFICATE Filing Requirement of Act 74, Mich. P.A. 1970

For corners in

KALKASKA	Located In:	Corner Code #
(County)		
1997 REMONUMENTATION		
1. Public Land Survey	T <u>26N</u> R <u>7W</u>	<u>C-12</u>
	T _____ R _____	_____
	T _____ R _____	_____
	T _____ R _____	_____
2. Property Controlling in Section	S _____ T _____ R _____	_____
	S _____ T _____ R _____	_____
3. Miscellaneous Property in Sec.	S _____ T _____ R _____	_____
	S _____ T _____ R _____	_____

Register of Deeds Stamp & File Number

4. Lot No. \_\_\_\_\_, Recorded Plat \_\_\_\_\_

5. Private Claims \_\_\_\_\_

	A	B	C	D	E	F	G	H	I	J	K	L	M	
1														
2	6			5			4			3			2	1
3														
4	7			8			9			10			11	12
5														
6	18			17			16			15			14	13
7														
8	19			20			21			22			23	24
9														
10	30			29			28			27			26	25
11														
12	31			32			33			34			35	36
13														

I, EUGENE FARRIER, in a field survey on SEPTEMBER 30, 1997 do hereby state that under requirements of P.A. 74, Michigan P.A. of 1970, the corner points mentioned in lines 1 and 2 above were in conformance with regulations and rules therefore as required in the current manual of survey instructions of the United States Department of the Interior, Bureau of Land Management or by a decree of a Court of Law and /or that the corner points mentioned in lines 3, 4 and 5 above were in conformance with the rules of the Michigan Board of Land Surveyors or by a Decree of a Court of Law; established, re-established, monumented, recovered, found as expressed below:


**NOTE:** Not more than 2 corners, all in the same town and range, may be recorded on this certificate.

A. Description of original monument and accessories and/or subsequent restoration:  
C-12: Cor. common Sec. 31 & 32, T26N-R7W, Orange Township  
 1849, GLO resurvey, set beech post, 6" Beech N74W, 21, 6" Beech S30E, 18  
 11-22-1900, W.S Merrill, Co. Surveyor, used cor. no accessories  
 12-26-1900, W.S. Merrill, Co. Surveyor, cor. listed iron stake no accessories  
 02-17-1995, Farrier Surveying, Survey, fd. Pipe, w/accessories

B. Description of corner evidence found and/or method applied in restoring or reestablishing corner:  
C-12: Cor. common Sec. 31 & 32, T26N-R7W, Orange Township.  
 Fd. 3/4" iron pipe w/accessories, set 5/8" x 18" rerod in pipe w/brass cap in mon. box. No GLO witnesses were fd. The Kalkaska Co. Peer group approved & accepted the above monument as the best available evidence of the position of the original corner.

C. Description of monument for corner and accessories established to perpetuate locating the position of the corner:  
C-12: Cor. common Sec. 31 & 32, T26N-R7W, Orange Township.  
 Fd. 3/4" iron pipe w/accessories, set 5/8" x 18" rerod in pipe w/brass cap in mon. box.  
 Fd. nail S25E fence post 47.72'  
 Fd. nail S40W 30" Maple 49.09'  
 Fd. North iron & cap 24594 33.00'  
 Set nail N87E 8" R. Pine 41.25'

**Ratified by Peer Group**  
**P.A. 345 - 1990 Kalkaska County**  
 Chairman Eugene Farrier  
 Date 1-29-98

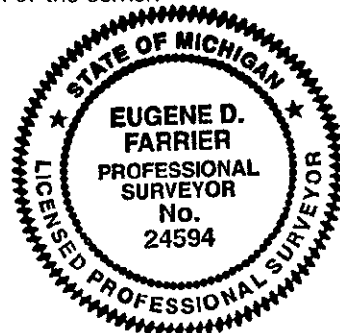

Signed by Eugene Farrier Date 2-3-98  
 Surveyor's Michigan License No. 24594



**3004831**  
 Page: 1 of 1  
 02/04/98 11:22A