

# SURVEY & REMONUMENTATION

MAR 2 1 1997 LAND CORNER RECORDATION CERTIFICATE

Filing Requirement of Act 74, Mich. P.A. 1970

For corners in

**COMMISSION**

KALKASKA

(County)

Located In:

Corner Code #11

1996 REMONUMENTATION

- |                                    |                          |       |       |
|------------------------------------|--------------------------|-------|-------|
| 1. Public Land Survey              | T <u>26N</u> R <u>7W</u> | _____ | _____ |
|                                    | T _____ R _____          | _____ | _____ |
|                                    | T _____ R _____          | _____ | _____ |
|                                    | T _____ R _____          | _____ | _____ |
| 2. Property Controlling in Section | S _____ T _____ R _____  | _____ | _____ |
|                                    | S _____ T _____ R _____  | _____ | _____ |
| 3. Miscellaneous Property in Sec.  | S _____ T _____ R _____  | _____ | _____ |
|                                    | S _____ T _____ R _____  | _____ | _____ |

4. Lot No. \_\_\_\_\_, Recorded Plat \_\_\_\_\_  
5. Private Claims \_\_\_\_\_

KALKASKA COUNTY, MICHIGAN  
RECEIVED

97 JAN 31 PM 3:19

*Joan Hall*  
REG. OF DEEDS

Register of Deeds Stamp & File Number

I, EUGENE FARRIER, in a field survey on July 1, 1996

do hereby certify that under requirements of P.A. 74, Michigan P.A. of 1970, the corner points mentioned in lines 1 and 2 above were in conformance with regulations and rules therefore as required in the current manual of survey instructions of the United States Department of the Interior, Bureau of Land Management or by a decree of a Court of Law and/or that the corner points mentioned in lines 3, 4 and 5 above were in conformance with the rules of the Michigan Board of Land Surveyors or by a Decree of a Court of Law; established, re-established, monumented, re-monumented, recovered, found as expressed below:

**NOTE: Not more than 4 corners, all in the same town and range, may be recorded on this certificate.**

	A	B	C	D	E	F	G	H	I	J	K	L	M
2		6		5		4		3		2		1	
3													
4		7		8		9		10		11		12	
5				●									
6		18		17		16		15		14		13	
7													
8		19		20		21		22		23		24	
9													
10		30		29		28		27		26		25	
11													
12		31		32		33		34		35		36	
13													

A. Description of original monument and accessories and/or subsequent restoration:

- D-05: Cor. common to Sec. 17 & 8, T26N-R7W, Orange Township  
1849, GLO resurvey, set Sugar post. 6" Beech N70W 13, 7" Beech S30E 17.  
May 05, 1903, W.S. Merrill, Co. Surveyor, used cor. no accessories.  
Jan 05, 1973, LCRC Liber 1 Pg. 160.  
Jan 05, 1973, J.H. Granger, used cor. Liber 1 Pg. 578.  
Nov 29, 1973, LCRC Liber 1 Pg. 289.  
05-20-1977, J.L. Fletcher, fd. 3/4" iron pipe. Liber 2 pgs. 2 of Survey.  
06-08-1977, LCRC Liber 2 pg. 12.  
07-30-1986, Farrier Surveying, fd. 1" iron in mon box. Survey #7986.  
05-09-1988, E.D. Farrier, Survey #5588, fd. 3/4" iron pipe w/ accessories.  
02-17-1992, E.D. Farrier, Survey #3192, fd. spike w/ accessories.

B. Description of corner evidence found and/or method applied in restoring or reestablishing corner:

- D-05: Cor. common to Sec. 17 & 8, T26N-R7W, Orange Township  
Found 1/2" iron pipe inside 1" iron pipe, that was inside 1 1/4" iron pipe w/ accessories. Pulled & Set 5/8" x 18" re-rod w/ Brass cap 0.5' below Bass Lk. rd. surface, cor falls 2' South of centerline of Bass Lk. rd. in line w/ old fence mound to the North. No G.L.O. witnesses were found. The Kalkaska Co. peer group approved & accepted the above monument as a careful and faithful perpetuation of the position of the original corner.


C. Description of monument for corner and accessories established to perpetuate locating the position of the corner:

- D-05: Cor. common to Sec. 17 & 8, T26N-R7W, Orange Township  
Found 1/2" iron pipe inside 1" iron pipe, that was inside 1 1/4" iron pipe w/ accessories. Pulled & Set 5/8" x 18" re-rod w/ Brass cap 0.5' below Bass Lk. rd. surface, cor falls 2' South of centerline of Bass Lk. rd. in line w/ old fence mound to the North.  
Set nail & tag N45E, 6" Wood Post (Cable Marker 277) 46.13'  
Set nail & tag S25W, 7" Red Pine, 65.23'  
Set nail & tag S55W, 6" Wood Post (Cable Marker 278) 48.47'  
Set nail & tag N40W, 4" Red Pine, 54.07'

Ratified by Peer Group  
P.A. 345 - 1990 Kalkaska County

Chairman Eugene Farrier

Date 1-21-97

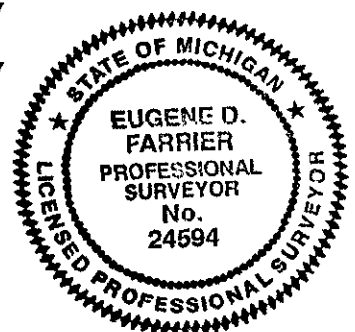

Signed by Eugene Farrier

Date 1-30-97

Surveyor's Michigan License No. 24594