

SURVEY & REMONUMENTATION

LAND CORNER RECORDATION CERTIFICATE
Filing Requirement of Act 74, Mich. P.A. 1970

For corners in MAR 21 1997

KALKASKA COUNTY, MICHIGAN
RECEIVED
97 JAN 31 PM 3:19

KALKASKA

COMMISSION

Located In:

Corner Code -#

1996 REMONUMENTATION

- | | | | | | |
|------------------------------------|---|------------|---|-----------|------------|
| 1. Public Land Survey | T | <u>26N</u> | R | <u>7W</u> | <u>D-7</u> |
| | T | _____ | R | _____ | _____ |
| | T | _____ | R | _____ | _____ |
| | T | _____ | R | _____ | _____ |
| 2. Property Controlling in Section | S | _____ | T | _____ | R |
| | S | _____ | T | _____ | R |
| 3. Miscellaneous Property in Sec. | S | _____ | T | _____ | R |
| | S | _____ | T | _____ | R |

Jasen Hall
REG. DEEDS

Register of Deeds Stamp & File Number

4. Lot No. _____, Recorded Plat _____
5. Private Claims _____

I, EUGENE FARRIER, in a field survey on Oct. 21, 19 96, do hereby certify that under requirements of P.A. 74, Michigan P.A. of 1970, the corner points mentioned in lines 1 and 2 above were in conformance with regulations and rules therefore as required in the current manual of survey instructions of the United States Department of the Interior, Bureau of Land Management or by a decree of a Court of Law and/or that the corner points mentioned in lines 3, 4 and 5 above were in conformance with the rules of the Michigan Board of Land Surveyors or by a Decree of a Court of Law; established, re-established, monumented, re-monumented, recovered, found as expressed below:

A	B	C	D	E	F	G	H	I	J	K	L	M
2	6	5	4	3	2	1						
3												
4	7	8	9	10	11	12						
5												
6	18	17	16	15	14	13						
7												
8	19	20	21	22	23	24						
9												
10	30	29	28	27	26	25						
11												
12	31	32	33	34	35	36						
13												

NOTE: Not more than 4 corners, all in the same town and range, may be recorded on this certificate.

A. Description of original monument and accessories and/or subsequent restoration:

- D-07: Cor. common to Sec. 17 & 20, T26N-R7W, Orange Township
1849, GLO resurvey, set Beech post. 6" Beech, S45E, 27, 13" Sugar, N45E, 14.
Apr 3, 1882, E. Mosher, Co. Surveyor, used cor. no accessories.
Sep 11, 1902, W.S. Merrill, Co. Surveyor, fd stone old corner, no accessories.
May 5, 1903, W.S. Merrill, Co. Surveyor, used cor. no accessories.
11-29-1973, LCRC Liber 1 pg. 287.
01-07-1974, J.L. Fletcher, fd 1/4"x2' steel bar. Liber 1 pg. 579 of Survey.
03-22-1974, J.L. Wilcox, fd 1/4"x 2' iron bar. Liber 1 pg. 499 of Survey.
07-30-1986, Farrier Surveying, fd. 1/2"x2' iron bar no accessories.
08-11-1988, E.D. Farrier, Survey #9588, used corner, no accessories.

B. Description of corner evidence found and/or method applied in restoring or reestablishing corner:


- D-07: Cor. common to Sec. 17 & 20, T26N-R7W, Orange Township
Found 1/2" x 18" R.B. & 1/2" x 2 1/2" Leaf spring w/ accessories. Pulled & Set 5/8" x 18" re-rod w/ Brass cap in mon box. No G.L.O. witnesses were found. The Kalkaska Co. peer group approved & accepted the above monument as the best evidence of the position of the original corner.

Ratified by Peer Group
P.A. 345 - 1990 Kalkaska County

Chairman Eugene Farrier
Date 1-21-97

C. Description of monument for corner and accessories established to perpetuate locating the position of the corner:

- D-07: Cor. common to Sec. 17 & 20, T26N-R7W, Orange Township
Found 1/2" x 18" R.B. & 1/2" x 2 1/2" Leaf spring w/ accessories. Pulled & Set 5/8" x 18" re-rod w/ Brass cap in mon box.
Set nail & tag N02E corner fence post, 29.05' (old wit).
Set nail & tag N59E 26" Maple, 61.40' (old wit).
Set nail & tag N70E Power Pole, 87.01'.
Set nail & tag South cor. fence post 49.80'.

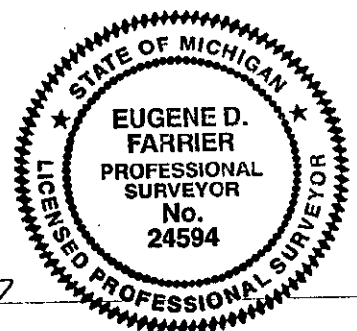

Signed by Eugene Farrier
Surveyor's Michigan License No. 24594

Date 1-30-97