

**SURVEY &
MONUMENTATION**

JAN 17 1996

**LAND CORNER RECORDATION CERTIFICATE
Filing Requirement of Act 74, Mich. P.A. 1970**

KALKASKA COUNTY, MICHIGAN
RECEIVED

95 DEC 27 AM 9:54

For corners in **COMMISSION**

KALKASKA

(County)

Located In:

Corner Code -#

1995 REMONUMENTATION

1. Public Land Survey	T	<u>26N</u>	R	<u>7W</u>	<u>E-3</u>
	T	_____	R	_____	_____
	T	_____	R	_____	_____
	T	_____	R	_____	_____
2. Property Controlling in Section	S	_____	T	_____	R
	S	_____	T	_____	R
3. Miscellaneous Property in Sec.	S	_____	T	_____	R
	S	_____	T	_____	R

Jean Hall
PLR OFFICER

Register of Deeds Stamp & File Number

4. Lot No. _____, Recorded Plat _____
5. Private Claims _____

A	B	C	D	E	F	G	H	I	J	K	L
2	6	5	4	3	2	1					
3											
4	7	8	9	10	11	12					
5											
6	16	17	18	15	14	13					
7											
8	19	20	21	22	23	24					
9											
10	30	29	28	27	26	25					
11											
12	31	32	33	34	35	36					
13											

I, EUGENE FARRIER, in a field survey on Nov. 6, 1995, do hereby certify that under requirements of P.A. 74, Michigan P.A. of 1970, the corner points mentioned in lines 1 and 2 above were in conformance with regulations and rules therefore as required in the current manual of survey instructions of the United States Department of the Interior, Bureau of Land Management or by a decree of a Court of Law and/or that the corner points mentioned in lines 3, 4 and 5 above were in conformance with the rules of the Michigan Board of Land Surveyors or by a Decree of a Court of Law; established, re-established, monumented, re-monumented, recovered, found as expressed below:

NOTE: Not more than 4 corners, all in the same town and range, may be recorded on this certificate.

A. Description of original monument and accessories and/or subsequent restoration:

E-3: Cor. common to Sec. 4, 5, 8 & 9, T26N-R7W, Orange
1849 GLO re-survey: set Bech post, Sgr 24", N49W, 22; Sgr 18", S26E, 24.
8-26-1895, E.B.Dennis, Co.Srv, used crnr, stone, no accessories.
1937, MDOT, fd. 1" iron pipe, w/accessories.
1-5-1973, J.H.Granger, CERT OF SURVEY, fd. iron, L.1 PG.258, rev.L.1 PG.578.
1-8-1973, LCRC(J.H.Granger), E-3, fd. iron in Mon.box, L.1 PG.160.
11-5-1975, LCRC(H.L.Fluhart), E-3, fd. 1" sq. bolt head/Mon.box, L.1 PG.366.
JULY-1978, A.L.Dragoo, CERT OF SURVEY, fd. iron, L.2 PG.276.
11-17-1978, J.L.Fletcher, CERT OF SURVEY, fd. iron in Mon.box, L.2 PG.278.
4-24-1987, LCRC(K.G.Stevenson), E-3, fd. 1" sq. bolt in Mon.box, L.2 P.322.
4-24-1987, K.G.Stevenson, CERT OF SURV, fd. 1" sq. bolt, L.1 PG.992.
10-10-1994, E.D.Farrier, CERT OF SRV, fd. bolt spike in Mon.box, L.3 PG.992.

B. Description of corner evidence found and/or method applied in restoring or reestablishing corner:


E-3: Cor. common to Sec. 4, 5, 8 & 9, T26N-R7W, Orange
Fd bolt spike in Mon.box, 1' South & 6.5' West of c/l Rd. Pulled & replaced with 5/8" x 18" R.B. w/brass cap. No GLO wit. were fd. The Kalkaska Co. peer group approved the above monument and is accepted as the best available evidence of the position of the original corner.

Ratified by Peer Group
P.A. 345 - 1990 Kalkaska County
Chairman Eugene Farrier
Date 12-19-95

C. Description of monument for corner and accessories established to perpetuate locating the position of the corner:

E-3: Cor. common to Sec. 4, 5, 8 & 9, T26N-R7W, Orange
Fd bolt spike. Pulled & replaced with 5/8" x 18" R.B. w/brass cap.
Set nail & tag S77E, 40" Maple, 197.21'
Set nail & tag S83W, 4" Elm, 86.92'
Fd. pknail N81E, top north end 18" C.M.P., 81.13'
Set nail & tag N46W, 12" Apple, 76.11'

Signed by Eugene Farrier Date 12-22-95
Surveyor's Michigan License No. 24594

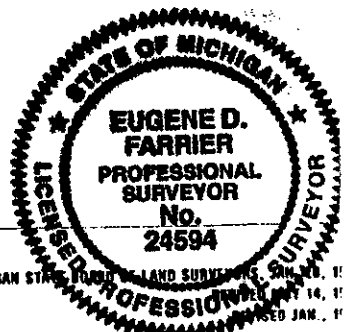

FORM APPROVED BY MICHIGAN STATE BOARD OF LAND SURVEYORS, JULY 14, 1978
REVISIONS JAN. 1981