

**SURVEY &  
REMONUMENTATION**

JAN 17 1996

**COMMISSION**

KALKASKA COUNTY, MICHIGAN  
RECEIVED

**LAND CORNER RECORDATION CERTIFICATE** 95 DEC 27 AM 9:54  
Filing Requirement of Act 74, Mich. P.A. 1970

For corners in

KALKASKA

(County)

Located In:

Corner Code #

1995 REMONUMENTATION

- |                                    |                          |            |
|------------------------------------|--------------------------|------------|
| 1. Public Land Survey              | T <u>26N</u> R <u>7W</u> | <u>E-4</u> |
|                                    | T _____ R _____          | _____      |
|                                    | T _____ R _____          | _____      |
|                                    | T _____ R _____          | _____      |
| 2. Property Controlling in Section | S _____ T _____ R _____  | _____      |
|                                    | S _____ T _____ R _____  | _____      |
| 3. Miscellaneous Property in Sec.  | S _____ T _____ R _____  | _____      |
|                                    | S _____ T _____ R _____  | _____      |

*Joan Hall*  
REG. OF DEEDS

Register of Deeds Stamp & File Number

4. Lot No. \_\_\_\_\_, Recorded Plat \_\_\_\_\_  
5. Private Claims \_\_\_\_\_

I, EUGENE FARRIER, in a field survey on Nov. 6, 19 95, do hereby certify that under requirements of P.A. 74, Michigan P.A. of 1970, the corner points mentioned in lines 1 and 2 above were in conformance with regulations and rules therefore as required in the current manual of survey instructions of the United States Department of the Interior, Bureau of Land Management or by a decree of a Court of Law and/or that the corner points mentioned in lines 3, 4 and 5 above were in conformance with the rules of the Michigan Board of Land Surveyors or by a Decree of a Court of Law; established, re-established, monumented, re-monumented, recovered, found as expressed below:

**NOTE: Not more than 4 corners, all in the same town and range, may be recorded on this certificate.**

	A	B	C	D	E	F	G	H	I	J	K	L	I
2	6		5		4		3		2		1		
3													
4	7		8		9		10		11		12		
5													
6	18		17		16		15		14		13		
7													
8	19		20		21		22		23		24		
9													
10	30		29		28		27		26		25		
11													
12	31		32		33		34		35		36		
13													

A. Description of original monument and accessories and/or subsequent restoration:

E-4: Cor. common to Sec. 8 & 9, T26N-R7W, Orange  
1849 GLO re-surv: set Bech 1/4 post, Sgr 14", N81E, 18; Bech 7", N71W, 24.  
11-17-1978, J.L.Fletcher, CERT OF SURV, fd. pknail.

B. Description of corner evidence found and/or method applied in restoring or reestablishing corner:


E-4: Cor. common to Sec. 8 & 9, T26N-R7W, Orange  
Did not find PK nail of record. Set 5/8" x 18" R.B. w/brass cap in Mon.box, 4.2' West of c/l of M-66. Set by single Proration using above mentioned survey by (Fletcher). Corner fell on good fence to East. No GLO wit. were fd. The Kalkaska Co. peer group approved the above monument as a careful and faithful reestablishment of the position of the original corner.

Ratified by Peer Group  
P.A. 345 - 1990 Kalkaska County

Chairman Eugene Farrier  
Date 12-19-95

C. Description of monument for corner and accessories established to perpetuate locating the position of the corner:

E-4: Cor. common to Sec. 8 & 9, T26N-R7W, Orange  
Set 5/8" x 18" R.B. w/brass cap w/Mon.box.  
East, Fd. 1/2" iron, 79.30'  
S45E, set 1/2" R.B., 45.00'  
S45W, set 1/2" R.B., 45.00''  
Set nail & tag West, P.P., 128.45'

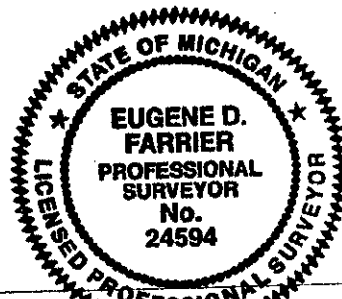

Signed by Eugene Farrier  
Surveyor's Michigan License No. 24594

Date 12-22-95

FORM APPROVED BY MICHIGAN STATE BOARD OF LAND SURVEYORS, JAN. 28, 197  
REVISED MAY 14, 197  
REVISED JAN., 199