

**SURVEY &
MONUMENTATION**

JAN 17 1996

LAND CORNER RECORDATION CERTIFICATE
Filing Requirement of Act 74, Mich. P.A. 1970

KALKASKA COUNTY, MICHIGAN
RECEIVED
95 DEC 27 AM 9:54

For corners in

COMMISSION

KALKASKA

(County)

Located in:

Corner Code #

1995 REMONUMENTATION


1. Public Land Survey	T	<u>26N</u>	R	<u>7W</u>	<u>E-5</u>
	T	_____	R	_____	_____
	T	_____	R	_____	_____
	T	_____	R	_____	_____
2. Property Controlling in Section	S	_____	T	_____	_____
	S	_____	T	_____	_____
3. Miscellaneous Property in Sec.	S	_____	T	_____	_____
	S	_____	T	_____	_____

Jean Hall
REG. OF DEEDS

Register of Deeds Stamp & File Number

4. Lot No. _____, Recorded Plat _____
5. Private Claims _____

I, EUGENE FARRIER, in a field survey on Nov. 6, 1995, do hereby certify that under requirements of P.A. 74, Michigan P.A. of 1970, the corner points mentioned in lines 1 and 2 above were in conformance with regulations and rules therefore as required in the current manual of survey instructions of the United States Department of the Interior, Bureau of Land Management or by a decree of a Court of Law and/or that the corner points mentioned in lines 3, 4 and 5 above were in conformance with the rules of the Michigan Board of Land Surveyors or by a Decree of a Court of Law; established, re-established, monumented, re-monumented, recovered, found as expressed below:

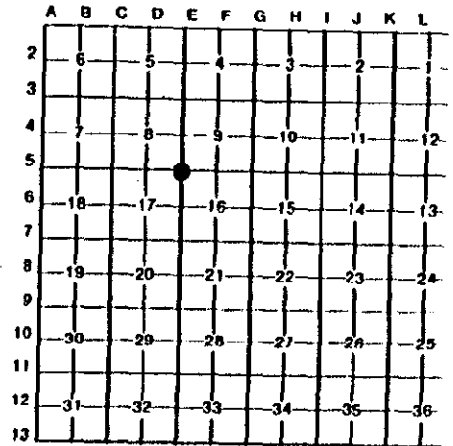

NOTE: Not more than 4 corners, all in the same town and range, may be recorded on this certificate.

A. Description of original monument and accessories and/or subsequent restoration:

- E-5: Cor. common to Sec. 8, 9, 16 & 17, T26N-R7W, Orange
- 1849 GLO re-survey: set Bech post, Sgr 16", N65W, 11; Hmlck 10", S26E, 18.
- 6-6-1876, D.E.McVee, Co.Srv, used crnr, no accessories.
- 1903, W.S.Merrill, fd. old cor, set iron stake.
- 1937, MDOT, fd. 5/8" iron bar, w/accessories.
- 1-5-1973, LCRC(J.H.Granger), E-5, fd. iron in Mon.box, L.1 PG.160.
- 11-29-1973, LCRC(J.L.Fletcher), E-5, fd. iron in Mon.box, L.1 PG.288.
- 7-17-1989, E.D.Farrier, CERT OF SURVEY, fd. 5/8" rerod in Mon.box.
- 9-19-1989, E.D.Farrier, CERT OF SURVEY, fd. 5/8" rerod in Mon.box.
- 2-17-1992, E.D.Farrier, CERT OF SURV, fd. Mon.box & 1/2" iron.

B. Description of corner evidence found and/or method applied in restoring or reestablishing corner:

E-5: Cor. common to Sec. 8, 9, 16 & 17, T26N-R7W, Orange
Fd 1/2" rebar in Mon.box, 1' West of c/l M-66. Pulled & replaced with 5/8" x 18" R.B. w/brass cap in old Mon.box. No GLO wit. were fd. The Kalkaska Co. peer group approved the above monument as a careful and faithful perpetuation of the position of the original corner

Ratified by Peer Group
P.A. 345 - 1990 Kalkaska County
Chairman *Eugene Farrier*
Date 12-19-95

C. Description of monument for corner and accessories established to perpetuate locating the position of the corner:

- E-5: Cor. common to Sec. 8, 9, 16 & 17, T26N-R7W, Orange
- Fd 1/2" rebar in Mon.box. Pulled & replaced with 5/8" x 18" R.B. w/brass cap in old Mon.box.
- Set nail & tag N65W, wood post, 159.50'
- N58E, rd. sign post, 54.41'
- Set nail & tag N77E, wood post, 173.50'
- S50W, rd. sign post, 54.09'

Signed by *Eugene Farrier*

Date 12-22-95

Surveyor's Michigan License No. 24594

