

SURVEY & REMONUMENTATION

MAR 21 1997

LAND CORNER RECORDATION CERTIFICATE
COMMISSION

Filing Requirement of Act 74, Mich. P.A. 1970

KALKASKA COUNTY, MICHIGAN
RECEIVED

97 JAN 31 PM 3:19

For corners in

KALKASKA

(County)

Located In:

Corner Code #/

1996 REMONUMENTATION

- | | | |
|---------------------------------------|--------------------------|------------|
| 1. Public Land Survey | T <u>26N</u> R <u>7W</u> | <u>E-7</u> |
| | T _____ R _____ | _____ |
| | T _____ R _____ | _____ |
| | T _____ R _____ | _____ |
| 2. Property Controlling in Section | S _____ T _____ R _____ | _____ |
| | S _____ T _____ R _____ | _____ |
| 3. Miscellaneous Property in Sec. | S _____ T _____ R _____ | _____ |
| | S _____ T _____ R _____ | _____ |
| 4. Lot No. _____, Recorded Plat _____ | | |
| 5. Private Claims _____ | | |

Joan Hall
REG. DEEDS

Register of Deeds Stamp & File Number

I, EUGENE FARRIER, in a field survey on Nov. 18, 19 96, do hereby certify that under requirements of P.A. 74, Michigan P.A. of 1970, the corner points mentioned in lines 1 and 2 above were in conformance with regulations and rules therefore as required in the current manual of survey instructions of the United States Department of the Interior, Bureau of Land Management or by a decree of a Court of Law and/or that the corner points mentioned in lines 3, 4 and 5 above were in conformance with the rules of the Michigan Board of Land Surveyors or by a Decree of a Court of Law; established, re-established, monumented, re-monumented, recovered, found as expressed below:

NOTE: Not more than 4 corners, all in the same town and range, may be recorded on this certificate.

	A	B	C	D	E	F	G	H	I	J	K	L	M
2	6	5	4	3	2	1							
3													
4	7	8	9	10	11	12							
5													
6	18	17	16	15	14	13							
7													
8	19	20	21	22	23	24							
9													
10	30	29	28	27	26	25							
11													
12	31	32	33	34	35	36							
13													

A. Description of original monument and accessories and/or subsequent restoration:

- E-07: Cor. common to Sec. 16, 17, 20, & 21, T26N-R7W, Orange Township 1849, GLO resurvey, used corner no accessories.
- Apr 3, 1882, E. Mosher, Co. Surveyor, used cor. no accessories.
- Sep 1885, E. Mosher, Co. Surveyor, used cor. no accessories.
- Sep 11, 1902, W.S. Merrill, Co. Surveyor, fd stone old corner, no accessories.
- Sep 17, 1902, W.S. Merrill, Co. Surveyor, used cor. no accessories.
- 11-22-1959, Arthur G. Ericson, used corner no accessories.
- 11-29-1973, LCRC Liber 1 pg. 287.
- 12-28-1978, J.L. Fletcher, fd 3/4" iron in mon. box. Liber 2 pg. 331 of Survey.
- 12-28-1978, LCRC Liber 2 pg. 172.
- 05-23-1979, J.L. Fletcher, fd 3/4" iron in mon. box. Liber 2 pg. 366 of Survey.
- 10-30-1981, E.D. Farrier, Survey #8981, used corner, no accessories.
- 08-11-1988, E.D. Farrier, Survey #9588, used corner, no accessories.
- 08-31-1989, J.G. Knapp, fd iron. Liber 3 pg. 335 of Survey.
- 06-30-1995, R.J. Kral, Survey #11095, fd 3/4" iron in mon. box w/ accessories.


B. Description of corner evidence found and/or method applied in restoring or reestablishing corner:

E-07: Cor. common to Sec. 16, 17, 20, & 21, T26N-R7W, Orange Township Found 1" Iron in Mon Box w/ accessories. Pulled & Set 5/8" x 18" re-rod w/ Brass cap in Mon Box in centerline of intersection of M-66 & Spencer Road. No G.L.O. witnesses found. The Kalkaska Co. peer group approved & accepted the above monument as the best available evidence of the position of the original corner.

C. Description of monument for corner and accessories established to perpetuate locating the position of the corner:

E-07: Cor. common to Sec. 16, 17, 20, & 21, T26N-R7W, Orange Township Found 1" Iron in Mon Box w/ accessories. Pulled & Set 5/8" x 18" re-rod w/ Brass cap in Mon Box in centerline of intersection of M-66 & Spencer Road.
 Found nail S68E Power Pole, 107.84'
 Found nail N78E Power Pole, 154.96'
 Found nail N20E Power Pole, 239.74'
 Found nail N46W Power Pole, 180.60'

Ratified by Peer Group
P.A. 345 - 1990 Kalkaska County
Chairman *Eugene Farrier*
Date 1-31-97

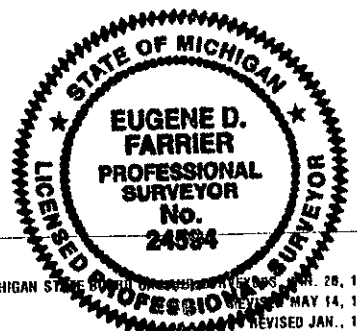

Signed by *Eugene Farrier* Date 1-31-97
 Surveyor's Michigan License No. 24594

MICHIGAN STATE BOARD OF PROFESSIONAL SURVEYORS, REVISED JAN., 1987