

**SURVEY &
REMONUMENTATION**

FEB 13 1998

SECTION

**LAND CORNER RECORDATION CERTIFICATE
Filing Requirement of Act 74, Mich. P.A. 1970**

For corners in

KALKASKA Located In: _____ Corner Code # _____
(County)
1997 REMONUMENTATION
1. Public Land Survey T. 26N R. 7W E-11
T. _____ R. _____
T. _____ R. _____
T. _____ R. _____
2. Property Controlling S. _____ T. _____ R. _____
in Section S. _____ T. _____ R. _____
3. Miscellaneous S. _____ T. _____ R. _____
Property in Sec. S. _____ T. _____ R. _____

Register of Deeds Stamp & File Number

4. Lot No. _____, Recorded Plat _____

5. Private Claims _____

I, EUGENE FARRIER, in a field survey on OCTOBER 24, 1997
do hereby state that under requirements of P.A. 74, Michigan P.A. of 1970, the corner points mentioned in lines 1 and 2 above were in conformance with regulations and rules therefore as required in the current manual of survey instructions of the United States Department of the Interior, Bureau of Land Management or by a decree of a Court of Law and /or that the corner points mentioned in lines 3, 4 and 5 above were in conformance with the rules of the Michigan Board of Land Surveyors or by a Decree of a Court of Law; established, re-established, monumented, recovered, found as expressed below:

	A	B	C	D	E	F	G	H	I	J	K	L	M
1													
2	6		5		4		3		2		1		
3													
4	7		8		9		10		11		12		
5													
6	18		17		16		15		14		13		
7													
8	19		20		21		22		23		24		
9													
10	30		29		28		27		26		25		
11													
12	31		32		33		34		35		36		
13													


NOTE: Not more than 2 corners, all in the same town and range, may be recorded on this certificate.

A. Description of original monument and accessories and/or subsequent restoration:
E-11: Cor. Common to Sec. 28, 29, 32, & 33, T26N-R7W Orange Twp.
 1849, GLO, resurvey, cor. in lake, 12" W. Birch North 1.27
 05-18-1880, Highway Survey, used cor., no accessories
 11-22-1900, W.S. Merrill Co. Surveyor, reestablished cor. from right tree of GLO survey (12" W. Birch North 1.27) and from notes of old Hwy survey by E. Mosher, set pine stake, 12" pine stump East 1.01, 14" pine stump S63E, 96
 12-1971, N.L. Parker #16939, LCR, fd. 1 1/2" pipe, w/accessories, Lib. 1, Pg. 47
 12-1971, N.L. Parker #16939, Cert. Survey, fd. 1 1/2" pipe, w/accessories, Lib. 1, Pg. 73
 10-20-1976, DNR, LCR, fd. 1 1/2" pipe & set Cedar post w/loc. Tag, w/accessories, Lib. 2, Pg. 69
 04-04-1987, Farrier Surveying, Cert. Survey, fd. 1" pipe (witnesses Lib. 2, Pg. 69)

B. Description of corner evidence found and/or method applied in restoring or reestablishing corner:
E-11: Cor. Common to Sec. 28, 29, 32, & 33, T26N-R7W Orange Twp.
 Fd. 1 1/2" iron pipe, w/Cedar post. Pulled and replaced with 5/8" x 36" rebar w/aluminum cap. No GLO witnesses were fd. The Kalkaska Co. Peer group approved and accepted the above monument as a careful and faithful perpetuation of the position of the original corner.

C. Description of monument for corner and accessories established to perpetuate locating the position of the corner:
E-11: Cor. Common to Sec. 28, 29, 32, & 33, T26N-R7W Orange Twp.
 Fd. 1 1/2" iron pipe, w/Cedar post. Pulled and replaced with 5/8" x 36" rebar w/aluminum cap.
 Set nail & tag N25E, 12" Hemlock, 57.98'
 Set nail & tag N58E, 12" Tw. Maple, 30.26'
 Set nail & tag S35E, 6" W. Pine, 43.86'
 Set nail & tag N35W, 4" Maple (clump), 37.07'

Ratified by Peer Group
 P.A. 345 - 1990 Kalkaska County
 Chairman Eugene Farrier
 Date 1-29-98

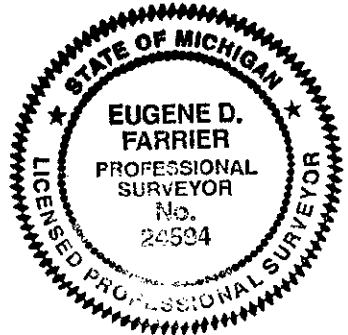

Signed by Eugene Farrier Date 2-3-98
 Surveyor's Michigan License No. 24594



3004839
 Page: 1 of 1
 02/04/98 11:22A