

**SURVEY &
REMONUMENTATION**

JAN 17 1996

**LAND CORNER RECORDATION CERTIFICATE
COMMISSION Filing Requirement of Act 74, Mich. P.A. 1970**

KALKASKA COUNTY, MICHIGAN
RECEIVED

95 DEC 27 AM 9:54

Joan Hall
REG. OF DEEDS

For corners in

<u>KALKASKA</u> (County)	Located In:	Corner Code #1
1995 REMONUMENTATION		
1. Public Land Survey	T <u>26N</u> R <u>7W</u>	<u>F-5</u>
	T _____ R _____	_____
	T _____ R _____	_____
	T _____ R _____	_____
2. Property Controlling in Section	S _____ T _____ R _____	_____
	S _____ T _____ R _____	_____
3. Miscellaneous Property in Sec.	S _____ T _____ R _____	_____
	S _____ T _____ R _____	_____
4. Lot No. _____, Recorded Plat _____		
5. Private Claims _____		

Register of Deeds Stamp & File Number

I, EUGENE FARRIER, in a field survey on Oct. 23, 19 95, do hereby certify that under requirements of P.A. 74, Michigan P.A. of 1970, the corner points mentioned in lines 1 and 2 above were in conformance with regulations and rules therefore as required in the current manual of survey instructions of the United States Department of the Interior, Bureau of Land Management or by a decree of a Court of Law and/or that the corner points mentioned in lines 3, 4 and 5 above were in conformance with the rules of the Michigan Board of Land Surveyors or by a Decree of a Court of Law; established, re-established, monumented, re-monumented, recovered, found as expressed below:

	A	B	C	D	E	F	G	H	I	J	K	L
2	6	5	4	3	2							
3												
4	7	8	9	10	11	12						
5												
6	18	17	16	15	14	13						
7												
8	19	20	21	22	23	24						
9												
10	30	29	28	27	26	25						
11												
12	31	32	33	34	35	36						
13												

NOTE: Not more than 4 corners, all in the same town and range, may be recorded on this certificate.

A. Description of original monument and accessories and/or subsequent restoration:

F-5: Cor. common to Sec. 9 & 16, T26N-R7W, Orange 1850 GLO re-survey: Set Bech post, Bech 10", N50W, 5; Sgr 6", S12W, 18. 10-1-1874, E.Mosher, Co.Surv, Hwy.Surv, on South line. 1893, W.S.Merrill, Co.Surv, surveyed on S. line. 10-21-1982, E.D.Farrier, CERT OF SURV, fd 5/8" bar, L.2 PG.744. 5-21-1986, E.D.Farrier, CERT OF SURV, fd 5/8" bar. 7-17-1989, E.D.Farrier, CERT OF SURV, fd 5/8" bar. 9-22-1989, E.D.Farrier, CERT OF SURV, fd 5/8" bar. 1-26-1990, LCRC(E.D.Farrier), F-5, fd. 5/8" bar, L.2 PG.400.


B. Description of corner evidence found and/or method applied in restoring or reestablishing corner:

F-5: Cor. common to Sec. 9 & 16, T26N-R7W, Orange Fd 1/2" x 12" iron pipe in c/l of Cool Rd. Pulled & replaced with 5/8" x 18" R.B. w/brass cap 0.3' below Rd. Surface. No GLO wits. were fd. The Kalkaska Co. peer group approved the above monument and is accepted as the best available evidence of the position of the original corner.

Ratified by Peer Group
P.A. 345 - 1990 Kalkaska County
Chairman *[Signature]*
Date 12-19-95

C. Description of monument for corner and accessories established to perpetuate locating the position of the corner:

F-5: Cor. common to Sec. 9 & 16, T26N-R7W, Orange Fd 1/2" x 12" iron pipe. Pulled & replaced with 5/8" x 18" R.B. w/brass cap 0.3' below Rd. Surface. Set nail & tag N40W, 26" Maple, 51.62' North, fd. iron w/cap #24594, 33.00' Set nail & tag S10E, 8" W. Pine, 59.60' South, fd. iron w/cap #24594, 33.00'

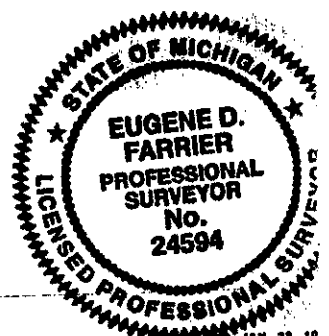

Signed by *[Signature]*
Surveyor's Michigan License No. 24594

Date 12-22-95