

**SURVEY &
MONUMENTATION**

JAN 17 1996

LAND CORNER RECORDATION CERTIFICATE

Filing Requirement of Act 74, Mich. P.A. 1970

KALKASKA COUNTY, MICHIGAN
RECEIVED

95 DEC 27 AM 9:54

Jean Hall
REG. DEEDS

For corners in


COMMISSION

<u>KALKASKA</u>	Located In:	Corner Code #
(County)		
1995 REMONUMENTATION		
1. Public Land Survey	T <u>26N</u> R <u>7W</u>	<u>G-3</u>
	T _____ R _____	_____
	T _____ R _____	_____
	T _____ R _____	_____
2. Property Controlling in Section	S _____ T _____ R _____	_____
	S _____ T _____ R _____	_____
3. Miscellaneous Property in Sec.	S _____ T _____ R _____	_____
	S _____ T _____ R _____	_____

Register of Deeds Stamp & File Number

4. Lot No. _____, Recorded Plat _____
5. Private Claims _____

I, EUGENE FARRIER, in a field survey on Oct. 19, 1995, do hereby certify that under requirements of P.A. 74, Michigan P.A. of 1970, the corner points mentioned in lines 1 and 2 above were in conformance with regulations and rules therefore as required in the current manual of survey instructions of the United States Department of the Interior, Bureau of Land Management or by a decree of a Court of Law and/or that the corner points mentioned in lines 3, 4 and 5 above were in conformance with the rules of the Michigan Board of Land Surveyors or by a Decree of a Court of Law; established, re-established, monumented, re-monumented, recovered, found as expressed below:

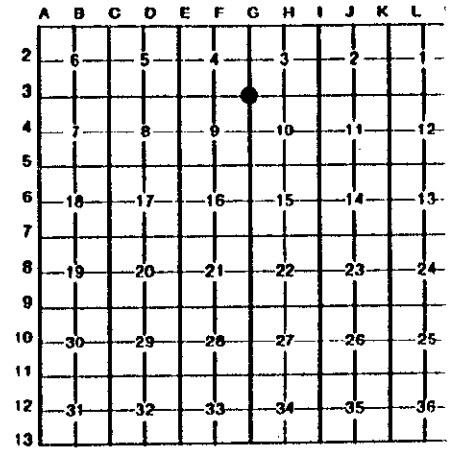

NOTE: Not more than 4 corners, all in the same town and range, may be recorded on this certificate.

A. Description of original monument and accessories and/or subsequent restoration:

G-3: Cor. common to Sec. 3, 4, 9 & 10, T26N-R7W, Orange
1849 GLO re-survey: set Sgr post, Sgr 18", S66W, 19; Sgr 11", N63E, 37.
11-8-1897, E.P.Beebe, Surv., Hwy. Surv. btwn Sec.4 & 5, stake & stone.
11-22-1900, W.S.Merrill, fnd. stone corner.
9-8-1911, W.S.Merrill, fnd. stone corner.
1982, E.D.Farrier, COS, Set 1/2" iron w/cap by retracing Merrill survey.
6-2-1993, E.D.Farrier, CERT OF SURVEY, fd. 1/2" iron w/cap.
6-6-1993, LCRC(E.D.Farrier), set 1/2" iron road w/cap.


B. Description of corner evidence found and/or method applied in restoring or reestablishing corner:

G-3: Cor. common to Sec. 3, 4, 9 & 10, T26N-R7W, Orange
Fd 1/2" iron, 3' North and 5' West c/l of Pontius & Mitchell Rds. Pulled & replaced with 5/8" x 18" R.B. w/brass cap 0.3' below Rd. Surface. No GLO wit. were fd. The Kalkaska Co. peer group approved the above monument as a careful and faithful reestablishment of the position of the original corner.

Ratified by Peer Group
P.A. 345 - 1990 Kalkaska County
Chairman *Eugene Farrier*
Date 12-13-95

C. Description of monument for corner and accessories established to perpetuate locating the position of the corner:

G-3: Cor. common to Sec. 3, 4, 9 & 10, T26N-R7W, Orange
Fd 1/2" iron. Pulled & replaced with 5/8" x 18" R.B. w/brass cap 0.3' below Rd. Surface.
Set nail & tag N40W, P.P., 97.70'
Set nail & tag N17E, 8" Beech, 63.85'
Set nail & tag N66E, 10" Beech in clump, 75.83'
Set nail & tag S44E, 12" R. Pine, 61.73'

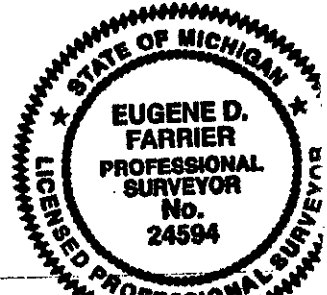

Signed by *Eugene Farrier* Date 12-22-95
Surveyor's Michigan License No. 24594