

**SURVEY &
MONUMENTATION**

JAN 17 1996

LAND CORNER RECORDATION CERTIFICATE
Filing Requirement of Act 74, Mich. P.A. 1970

KALKASKA COUNTY, MI
RECEIVED
95 DEC 27 AM 9:

For corners in

COMMISSION

Joan Hall
REG. OF DEEDS

KALKASKA

(County)

Located In:

Corner Code #

1995 REMONUMENTATION

- | | | |
|---------------------------------------|--------------------------|------------|
| 1. Public Land Survey | T <u>26N</u> R <u>7W</u> | <u>G-4</u> |
| | T _____ R _____ | _____ |
| | T _____ R _____ | _____ |
| | T _____ R _____ | _____ |
| 2. Property Controlling in Section | S _____ T _____ R _____ | _____ |
| | S _____ T _____ R _____ | _____ |
| 3. Miscellaneous Property in Sec. | S _____ T _____ R _____ | _____ |
| | S _____ T _____ R _____ | _____ |
| 4. Lot No. _____, Recorded Plat _____ | | |
| 5. Private Claims _____ | | |

Register of Deeds Stamp & File Number

I, EUGENE FARRIER, in a field survey on Nov. 6, 19 95, do hereby certify that under requirements of P.A. 74, Michigan P.A. of 1970, the corner points mentioned in lines 1 and 2 above were in conformance with regulations and rules therefore as required in the current manual of survey instructions of the United States Department of the Interior, Bureau of Land Management or by a decree of a Court of Law and/or that the corner points mentioned in lines 3, 4 and 5 above were in conformance with the rules of the Michigan Board of Land Surveyors or by a Decree of a Court of Law; established, re-established, monumented, re-monumented, recovered, found as expressed below:

A	B	C	D	E	F	G	H	I	J	K	L
2	6	5	4	3	2	1					
3											
4	7	8	9	10	11	12					
5											
6	18	17	16	15	14	13					
7											
8	19	20	21	22	23	24					
9											
10	30	29	28	27	26	25					
11											
12	31	32	33	34	35	36					
13											

NOTE: Not more than 4 corners, all in the same town and range, may be recorded on this certificate.

A. Description of original monument and accessories and/or subsequent restoration:

G-4: Cor. common to Sec. 9 & 10, T26N-R7W, Orange 1849 GLO re-survey: set Sgr 1/4 post, Sgr 20", S45W, 23; Bech 14", N52E, 37. 12-16-1994, E.D. Farrier, CERT OF SURVEY, fd. 1/2" iron rod.

B. Description of corner evidence found and/or method applied in restoring or reestablishing corner:

G-4: Cor. common to Sec. 9 & 10, T26N-R7W, Orange Fd 1/2" x 18" R.B., 4' West of c/l of Mitchell Rd. Pulled & replaced with 5/8" x 18" R.B. w/brass cap 0.5' below grade. No GLO wit. were fd. The Kalkaska Co. peer group approved the above monument as a careful and faithful reestablishment of the position of the original corner.


Ratified by Peer Group
P.A. 345 - 1990 Kalkaska County

Chairman *Eugene Farrier*

Date 12-19-95

C. Description of monument for corner and accessories established to perpetuate locating the position of the corner:

G-4: Cor. common to Sec. 9 & 10, T26N-R7W, Orange Fd 1/2" x 18" R.B. Pulled & replaced with 5/8" x 18" R.B. w/brass cap 0.5' below Rd. Surface.
Set nail & tag N35W, 16" Maple, 29.00'
Set nail & tag S40W, 13" Maple, 37.48'
Set nail & tag S35E, 30" Maple, 42.88'
Set nail & tag S70E, 10" R. Pine, 39.18'

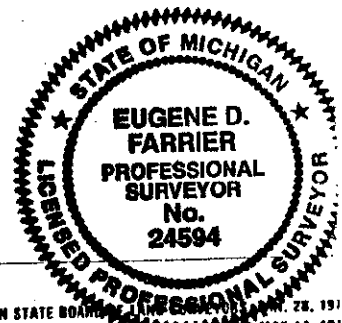

Signed by *Eugene Farrier*

Date 12-22-95

Surveyor's Michigan License No. 24594

FORM APPROVED BY MICHIGAN STATE BOARD OF SURVEYORS JAN. 28, 1971
REVISED MAY 14, 1971
REVISED JAN., 1971