

JAN 17 1996

KALKASKA COUNTY, MICHIGAN RECEIVED

95 DEC 27 AM 9:54

LAND CORNER RECORDATION CERTIFICATE
COMMISSION Filing Requirement of Act 74, Mich. P.A. 1970

For corners in

KALKASKA

(County)

Located In:

Corner Code #1


1995 REMONUMENTATION

| | | | | | |
|------------------------------------|---|-----|---|----|-----|
| 1. Public Land Survey | T | 26N | R | 7W | G-5 |
| | T | | R | | |
| | T | | R | | |
| | T | | R | | |
| 2. Property Controlling in Section | S | | T | R | |
| | S | | T | R | |
| 3. Miscellaneous Property in Sec. | S | | T | R | |
| | S | | T | R | |

Jean Hall
REG. DEEDS

Register of Deeds Stamp & File Number

4. Lot No. _____, Recorded Plat _____
5. Private Claims _____

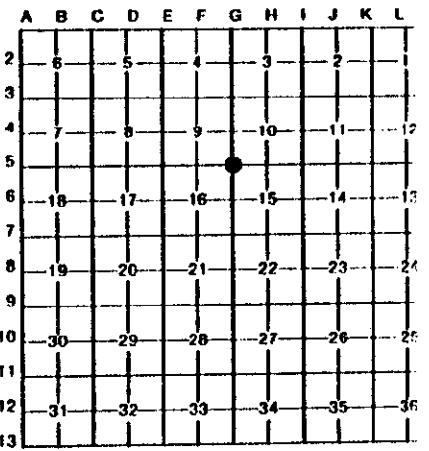

I, EUGENE FARRIER, in a field survey on Nov. 6, 19 95, do hereby certify that under requirements of P.A. 74, Michigan P.A. of 1970, the corner points mentioned in lines 1 and 2 above were in conformance with regulations and rules therefore as required in the current manual of survey instructions of the United States Department of the Interior, Bureau of Land Management or by a decree of a Court of Law and/or that the corner points mentioned in lines 3, 4 and 5 above were in conformance with the rules of the Michigan Board of Land Surveyors or by a Decree of a Court of Law; established, re-established, monumented, re-monumented, recovered, found as expressed below:

NOTE: Not more than 4 corners, all in the same town and range, may be recorded on this certificate.

A. Description of original monument and accessories and/or subsequent restoration:

- G-5: Cor. common to Sec. 9, 10, 15 & 16, T26N-R7W, Orange 1849 GLO re-survey: set Bech 1/4 post, Sgr 20", S21W, 22; Bech 13", N47E, 34.
- 6-6-1876, D.E.McVee, Co.Surv., Hwy.Surv., used crnr, no accessories.
- 11-29-1901, W.S.Merrill, Co.Surv., used crnr, no accessories.
- 10-21-1982, E.D.Farrier, CERT OF SURV, fd. 1/2" rod w/cap, L.2 PG.744.
- 7-27-1988, E.D.Farrier, CERT OF SURV, fd. 1/2" rod w/cap.
- 7-17-1989, LCRC(E.D.Farrier), G-5, fd. 1/2" rod w/cap #13030, L.2 PG.400.
- 12-16-1994, E.D.Farrier, CERT OF SURVEY, fd. 1/2" iron rod w/cap.

B. Description of corner evidence found and/or method applied in restoring or reestablishing corner:

G-5: Cor. common to Sec. 9, 10, 15 & 16, T26N-R7W, Orange
Fd 1/2" iron rod in c/l of Road. Pulled & dug down to original grade to retrieve old limestone column from county road records. Fd. (2) limestone rocks beneath iron. Set 5/8" x 18" R.B. w/brass cap 0.3' below Rd. Surface. No GLO wit. were fd. The Kalkaska Co. peer group approved the above monument and is accepted as the best available evidence of the position of the original corner.

Ratified by Peer Group
P.A. 345 - 1990 Kalkaska County

Chairman *Eugene Farrier*

Date 12-19-95

C. Description of monument for corner and accessories established to perpetuate locating the position of the corner:

- G-5: Cor. common to Sec. 9, 10, 15 & 16, T26N-R7W, Orange
Fd 1/2" iron rod. Pulled & replaced with 5/8" x 18" R.B. w/brass cap 0.3' below Rd. Surface.
- Set nail & tag N26W, AT&T marker (wood post), 66.88'
- Set nail & tag N37E, AT&T marker (wood post), 67.61'
- Set nail & tag S40W, 5" Elm, 65.50'
- Set nail & tag N53W, 5" Tw. Maple, 62.51'



Signed by *Eugene Farrier*

Date 12-22-95

Surveyor's Michigan License No. 24594