

MAR 01 2000

SECTION

LAND CORNER RECORDATION CERTIFICATE
Filing Requirement of Act 74, Mich. P.A. 1970

For corners in

KALKASKA (County)
1999 REMONUMENTATION
1. Public Land Survey

Located In: Corner Code #

T 25N R 7W G-1
T 26N R 7W G-13
T R
T R
S T R
S T R
S T R
S T R

Barcode with text: 3020166 Page: 1 of 1 02/04/2000 03:40P REMON LB: B PG: 112

Kalkaska County Jean Hall, Register

4. Lot No. , Recorded Plat

5. Private Claims

Grid table with columns A-M and rows 1-13. Contains numbers 1-36 and corner markers.

I, EUGENE FARRIER, in a field survey on November 4, 1999 do hereby state that under requirements of P.A. 74, Michigan P.A. of 1970, the corner points mentioned in lines 1 and 2 above were in conformance with regulations and rules therefore as required in the current manual of survey instructions of the United States Department of the Interior, Bureau of Land Management or by a decree of a Court of Law and /or that the corner points mentioned in lines 3, 4 and 5 above were in conformance with the rules of the Michigan Board of Land Surveyors or by a Decree of a Court of Law; established, re-established, monumented, recovered, found as expressed below:

NOTE: Not more than 2 corners, all in the same town and range, may be recorded on this certificate.


A. Description of original monument and accessories and/or subsequent restoration:
G-1: Sec. Cor. Common to Sec. 3 & 4, T25N-R7W, Garfield Township; G-13: Sec. 33 & 34, T26N-R7W, Orange Township

1853, G.L.O. Resurvey, V.W. Caukin (Deputy Surveyor) Co. Survey Notes, Pg. 13, set post cor., Sugar 10", N37°E, 30 Lks; Sugar 24", N42°W, 52 Lks.
1903, Survey, by W.S. Merrill (Co. Surveyor) Co. Survey Bk 25, Pgs. 2 & 3, visited corner, no accessories.
1974, LCRC, by J.L. Fletcher, recorded in Liber 1, Pg. 334, Northeast Section corner was re-established by occupation, set 1/2" rerod, anchor pole, N50°E, 37.02'; power pole, S45°W, 34.78'; 4" Pine, N20°W, 97.43'.
1993, Survey, by E. Farrier (Co. Surveyor), found 1/2" iron, same witnesses as Fletcher (1993),
1993, Survey, by Farrier Surveying, found iron & cap #19830 in centerline of road intersection, set nail N40°E, 4" Elm, 50.25'; set nail S55°W, power pole, 41.82'; set iron West 33.00' cap #24594, set nail N55°W, service pole, 40.85'

B. Description of corner evidence found and/or method applied in restoring or reestablishing corner:
G-1: Sec. Cor. Common to Sec. 3 & 4, T25N-R7W, Garfield Township; G-13: Sec. 33 & 34, T26N-R7W, Orange Township

Found 1/2" rerod & cap #19830 in centerline 3-way road int. and in centerline trail to West.
N40°E, 50.25', 6" Elm, found nail
S55°W, 41.82', power pole, found nail
West, 33.00', iron & cap #24594
N55°W, 40.85', service pole, found nail
No G.L.O. witnesses were found.

Ratified by Peer Group
P.A. 345 - 1990 Kalkaska County
Chairman Eugene Farrier
Date 02-03-00

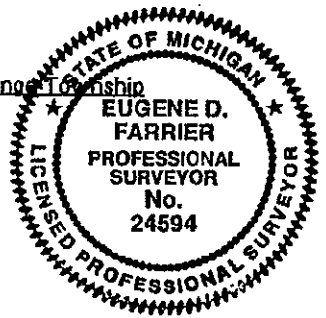

C. Description of monument for corner and accessories established to perpetuate locating the position of the corner:
G-1: Sec. Cor. Common to Sec. 3 & 4, T25N-R7W, Garfield Township; G-13: Sec. 33 & 34, T26N-R7W, Orange Township

Found 1/2" rerod & cap #19830 in centerline 3-way road int. and in centerline trail to West. Pulled & set 5/8" X 18" rerod w/brass cap.
N40°E, 50.25', 6" Elm, found nail
S55°W, 41.82', power pole, found nail
West, 33.00', iron & cap #24594
N55°W, 40.85', service pole, found nail

Kalkaska County Peer Group accepted the above monument as a careful and faithful reestablishment of the position of the original corner.

Signed by Eugene Farrier
Michigan License No. 24594

Date 02-04-00 Surveyor's