

JAN 17 1996

LAND CORNER RECORDATION CERTIFICATE
COMMISSION Filing Requirement of Act 74, Mich. P.A. 1970

KALKASKA COUNTY, MICHIGAN
RECEIVED

95 DEC 27 AM 9:54

For corners in

KALKASKA

(County)

1995 REMONUMENTATION

| | | |
|---------------------------------------|-------------------------|-------|
| 1. Public Land Survey | T 26N R 7W | H-1 |
| | T _____ R _____ | _____ |
| | T _____ R _____ | _____ |
| | T _____ R _____ | _____ |
| 2. Property Controlling in Section | S _____ T _____ R _____ | _____ |
| | S _____ T _____ R _____ | _____ |
| 3. Miscellaneous Property in Sec. | S _____ T _____ R _____ | _____ |
| | S _____ T _____ R _____ | _____ |
| 4. Lot No. _____, Recorded Plat _____ | | |
| 5. Private Claims _____ | | |

Jean Hall
REG. OF DEEDS

Register of Deeds Stamp & File Number

I, EUGENE FARRIER, in a field survey on Dec. 5, 19 95, do hereby certify that under requirements of P.A. 74, Michigan P.A. of 1970, the corner points mentioned in lines 1 and 2 above were in conformance with regulations and rules therefore as required in the current manual of survey instructions of the United States Department of the Interior, Bureau of Land Management or by a decree of a Court of Law and/or that the corner points mentioned in lines 3, 4 and 5 above were in conformance with the rules of the Michigan Board of Land Surveyors or by a Decree of a Court of Law; established, re-established, monumented, re-monumented, recovered, found as expressed below:

| | | | | | | | | | | | | |
|----|----|---|----|---|----|---|----|---|----|---|----|---|
| | A | B | C | D | E | F | G | H | I | J | K | L |
| 2 | 8 | | 5 | | 4 | | 3 | | 2 | | | |
| 3 | | | | | | | | | | | | |
| 4 | 7 | | 6 | | 8 | | 10 | | 11 | | 12 | |
| 5 | | | | | | | | | | | | |
| 6 | 18 | | 17 | | 16 | | 15 | | 14 | | 13 | |
| 7 | | | | | | | | | | | | |
| 8 | 19 | | 20 | | 21 | | 22 | | 23 | | 24 | |
| 9 | | | | | | | | | | | | |
| 10 | 30 | | 29 | | 28 | | 27 | | 26 | | 25 | |
| 11 | | | | | | | | | | | | |
| 12 | 31 | | 32 | | 33 | | 34 | | 35 | | 36 | |
| 13 | | | | | | | | | | | | |

NOTE: Not more than 4 corners, all in the same town and range, may be recorded on this certificate.

A. Description of original monument and accessories and/or subsequent restoration:

H-1: N 1/4 Cor. of Sec. 3, T26N-R7W, Orange
This position not established by original governmental surveyors.
6-14-1876, D.E.McVee, Co.Surv, Hwy.Surv, surveyed South line, used crnr.
12-18-1972, J.H.Granger, CERT OF SURVEY, Set 1/2" iron pipe, L.1 PG.259.
12-18-1972, LCRC(J.H.Granger), H-1, Set 1/2" iron pipe, L.1 PG.157.


B. Description of corner evidence found and/or method applied in restoring or reestablishing corner:

H-1: N 1/4 Cor. of Sec. 3, T26N-R7W, Orange
Did not find 1/2" iron pipe of record or wits. (Granger 1972). Reset by single Pro. Set 5/8" x 18" R.B. w/brass cap in c/l of Anderson Rd. 0.3' below grade. The Kalkaska Co. peer group approved the above monument as the best available evidence of the position of the corner.

Ratified by Peer Group
P.A. 345 - 1990 Kalkaska County
Chairman *Eugene Farrier*
Date 12-19-95

C. Description of monument for corner and accessories established to perpetuate locating the position of the corner:

H-1: N 1/4 Cor. of Sec. 3, T26N-R7W, Orange
Did not find 1/2" iron pipe. Set 5/8" x 18" R.B. w/brass cap in c/l of Anderson Rd. 0.3' below grade by single Pro.
Set nail & tag S33E, 6" R. Pine, 63.42'
Set nail & tag S05W, 12" R. Pine, 57.78'
Set nail & tag N58E, 6" Elm (clump), 44.74'
East, S 1/4 Cor, Sec. 34, T27N-R7W, Kal.Co.Mon., 99.05'

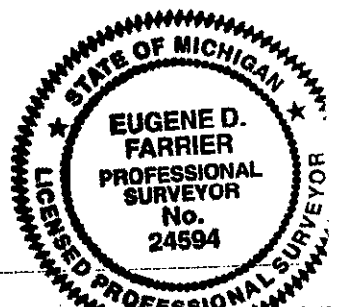

Signed by *Eugene Farrier*
Surveyor's Michigan License No. 24594

Date 12-22-95