SURVEY & MONUMENTATION

JAN 17 1996

COMMISSION

KALKASKA COUNTY, MICHIGAN RECEIVED

95 DEC 27 AM 9:54

REG OF DEEDS

LAND CORNER RECORDATION CERTIFICATE

Filing Requirement of Act 74, Mich. P.A. 1970

For corners in KALKASKA (County)

1995 REMONUMENTATION

		Located In:	Corner Code #1
1. Public Land Survey		T 26N R 7W	H-3
		T ___ R ___	
		T ___ R ___	
		T ___ R ___	
2. Property Controlling	S ___	T ___ R ___	
in Section	S ___	T ___ R ___	
3. Miscellaneous	S ___	T ___ R ___	
Property in Sec.	S ___	T ___ R ___	

Register of Deeds Stamp & File Number

4. Lot No. _____, Recorded Plat _____
5. Private Claims _____

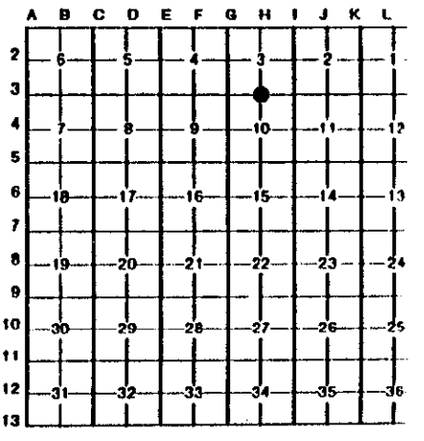

I, EUGENE FARRIER, in a field survey on Oct. 19, 19 95, do hereby certify that under requirements of P.A. 74, Michigan P.A. of 1970, the corner points mentioned in lines 1 and 2 above were in conformance with regulations and rules therefore as required in the current manual of survey instructions of the United States Department of the Interior, Bureau of Land Management or by a decree of a Court of Law and/or that the corner points mentioned in lines 3, 4 and 5 above were in conformance with the rules of the Michigan Board of Land Surveyors or by a Decree of a Court of Law; established, re-established, monumented, re-monumented, recovered, found as expressed below:

NOTE: Not more than 4 corners, all in the same town and range, may be recorded on this certificate.

A. Description of original monument and accessories and/or subsequent restoration:

H-3: Cor. common to Sec. 3 & 10, T26N-R7W, Orange
1850 GLO re-survey: Set Bech 1/4 post, Sgr 10",S80E,18; Sgr 14",N31W,27.
9-8-1911, W.S.Merrill, Co.Surv, HwySurv, stone w/buried hoop iron.
5-23-1991, N.L.Way, CERT OF SURVEY, fd. 1 1/4" iron.
8-30-1993, LCRC(E.D.Farrier), H-3, fd. iron w/cap.
12-16-1994, E.D.Farrier, CERT OF SURVEY, fd. 1/2" iron w/cap.

B. Description of corner evidence found and/or method applied in restoring or reestablishing corner:

H-3: Cor. common to Sec. 3 & 10, T26N-R7W, Orange
Fd 1/2" iron w/cap #28482 over old buggy axle in c/l Pontius Rd. Pulled & replaced with 5/8" x 18" R.B. w/brass cap. No GLO wit. were fd. The Kalkaska Co. peer group approved the above monument and is accepted as the best available evidence of the position of the original corner.

Ratified by Peer Group
P.A. 345 - 1990 Kalkaska County
Chairman [signature]
Date 12-19-95

C. Description of monument for corner and accessories established to perpetuate locating the position of the corner:

H-3: Cor. common to Sec. 3 & 10, T26N-R7W, Orange
Fd 1/2" iron w/cap #28482. Pulled & replaced with 5/8" x 18" R.B. w/brass cap.
Set nail & tag N30E, 30" Maple, 41.31'
Set nail & tag S40E, 6" R. Pine, 58.05'
Set nail & tag S50W, 5" Elm, 40.08'
Set nail & tag N25W, 7" R. Pine, 51.14'

STATE OF MICHIGAN
EUGENE D. FARRIER
PROFESSIONAL SURVEYOR
No. 24594
LICENSED PROFESSIONAL SURVEYOR

Signed by [signature] 12-22-95

Surveyor's Michigan License No. 24594

FORM APPROVED BY MICHIGAN STATE BOARD OF PROFESSIONAL SURVEYORS JAN. 28, 19
REVISED MAY 14, 19
REVISED JAN., 19