

MAR 01 2000

SECTION

LAND CORNER RECORDATION CERTIFICATE
Filing Requirement of Act 74, Mich. P.A. 1970

For corners in

KALKASKA

Located In:

Corner Code #

(County)

1999 REMONUMENTATION

1. Public Land Survey

T. 25N R. 7W

H-1

T. 26N R. 7W

H-13

T. _____ R. _____

T. _____ R. _____

2. Property Controlling in Section

S. _____ T. _____ R. _____

S. _____ T. _____ R. _____

3. Miscellaneous Property in Sec.

S. _____ T. _____ R. _____

S. _____ T. _____ R. _____



3020175
Page: 1 of 1
02/04/2000 03:40P
REMON
LB: 6 PG: 121

4. Lot No. _____, Recorded Plat _____

5. Private Claims _____

I, EUGENE FARRIER, in a field survey on November 4, 1999, do hereby state that under requirements of P.A. 74, Michigan P.A. of 1970, the corner points mentioned in lines 1 and 2 above were in conformance with regulations and rules therefore as required in the current manual of survey instructions of the United States Department of the Interior, Bureau of Land Management or by a decree of a Court of Law and for that the corner points mentioned in lines 3, 4 and 5 above were in conformance with the rules of the Michigan Board of Land Surveyors or by a Decree of a Court of Law; established, re-established, monumented, recovered, found as expressed below:

NOTE: Not more than 2 corners, all in the same town and range, may be recorded on this certificate.

	A	B	C	D	E	F	G	H	I	J	K	L	M
1													
2	6		5			4			3		2		1
3													
4	7		8			9			10		11		12
5													
6	10		17			16			15		14		13
7													
8	19		20			21			22		23		24
9													
10	30		29			28			27		26		25
11													
12	31		32			33			34		35		36
13													

A. Description of original monument and accessories and/or subsequent restoration:

H-1: 1/4 Cor. Common to Sec. 3, T25N-R7W, Garfield Twp; H-13: Sec. 34, T26N-R7W, Orange Twp.

1853, G.L.O. Resurvey, by V.W. Caukin (Deputy Surveyor) Co. Survey Notes, Pg 13, Sugar 24", 1/4 Sec. cor.

1992, Survey, by E. Farrier (Co. Surveyor), set iron & cap #24594 in center road; S65°W, 58.94', power pole, S30°W, 60.73', 14" Twin Maple; N15°W, 34.00', fence post; N55°E, 53.34', service pole, set MPOL

1993, Survey, by E. Farrier (Co. Surveyor), found 1/2" iron & cap, wit. same as 1992

B. Description of corner evidence found and/or method applied in restoring or reestablishing corner:

H-1: 1/4 Cor. Common to Sec. 3, T25N-R7W, Garfield Twp; H-13: Sec. 34, T26N-R7W, Orange Twp.

Found 1/2" X 18" iron & cap #24594 in centerline of E-W road, 11' East of fence to North & 27' East of fence to South.

S65°W, 58.94', power pole, found nail

N15°W, 34.00', corner fence post, found nail

N55°E, 53.34', service pole, found nail


S30°W, 60.73', 18" Twin Maple, found nail

No G.L.O. witnesses were found.

Ratified by Peer Group
P.A. 345 - 1990 Kalkaska County

Chairman Eugene Farrier

Date 02-03-00

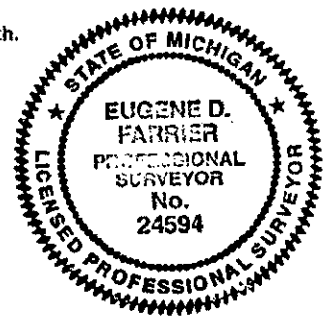

C. Description of monument for corner and accessories established to perpetuate locating the position of the corner:

H-1: 1/4 Cor. Common to Sec. 3, T25N-R7W, Garfield Twp; H-13: Sec. 34, T26N-R7W, Orange Twp.

Found 1/2" X 18" iron & cap #24594 in centerline of E-W road, 11' East of fence to North & 27' East of fence to South. Pulled & replaced with 5/8" X 18" rod w/ brass cap.

S65°W, 58.94', power pole, found nail

N15°W, 34.00', corner fence post, found nail

N55°E, 53.34', service pole, found nail

S30°W, 60.73', 18" Twin Maple, found nail

Kalkaska County Peer Group accepted the above monument as a careful and faithful reestablishment of the position of the original corner.

Signed by Eugene Farrier
Surveyor's Michigan License No. 24594

Date 02-04-00