

95 DEC 27 AM 9:55

LAND CORNER RECORDATION CERTIFICATE  
Filing Requirement of Act 74, Mich. P.A. 1970

JAN 17 1996

For corners in

KALKASKA

COMMISSION

Located In:

Corner Code #

1995 REMONUMENTATION

1. Public Land Survey

T 26N R 7W

I-2

T

R

T

R

T

R

2. Property Controlling  
in Section

S

T

R

S

T

R

3. Miscellaneous  
Property in Sec.

S

T

R

S

T

R

4. Lot No. \_\_\_\_\_, Recorded Plat \_\_\_\_\_

5. Private Claims \_\_\_\_\_

*Joan Hall*  
REG. DE OFFIC.

Register of Deeds Stamp & File Number

	A	B	C	D	E	F	G	H	I	J	K	L
2	6	5	4	3	2							
3												
4	7	8	9	10	11	12						
5												
6	18	17	16	15	14	13						
7												
8	19	20	21	22	23	24						
9												
10	30	29	28	27	26	25						
11												
12	31	32	33	34	35	36						
13												

I, EUGENE FARRIER, in a field survey on Oct. 23, 19 95, do hereby certify that under requirements of P.A. 74, Michigan P.A. of 1970, the corner points mentioned in lines 1 and 2 above were in conformance with regulations and rules therefore as required in the current manual of survey instructions of the United States Department of the Interior, Bureau of Land Management or by a decree of a Court of Law and/or that the corner points mentioned in lines 3, 4 and 5 above were in conformance with the rules of the Michigan Board of Land Surveyors or by a Decree of a Court of Law; established, re-established, monumented, re-monumented, recovered, found as expressed below:

NOTE: Not more than 4 corners, all in the same town and range, may be recorded on this certificate.

A. Description of original monument and accessories and/or subsequent restoration:

- I-2: Cor. common to Sec. 2 & 3, T26N-R7W, Orange 1849 GLO re-survey: 18" Sugar Maple, 1/4 corner.
- 6-6-1876, D.E.McVee, Co.Surv., HwySurv., used crnr, no accessories.
- 4-7-1988, LCRC(E.D.Farrier), I-2, Set 1/2" rerod w/cap.
- 4-11-1988, E.D.Farrier, CERT OF SURVEY, Set 1/2" rerod w/cap.
- 6-3-1993, E.D.Farrier, CERT OF SURV, fd. 1/2" rerod w/cap, L.1 PG.759.
- 5-27-1994, E.D.Farrier, CERT OF SURVEY, fd. 1/2" iron rod w/cap.


B. Description of corner evidence found and/or method applied in restoring or reestablishing corner:

I-2: Cor. common to Sec. 2 & 3, T26N-R7W, Orange Fd 1/2" R.B. w/cap, 2' East c/l Saunders Rd. Pulled & replaced with 5/8" x 18" R.B. w/brass cap 0.3' below Rd. Surface w/Mon.box. No GLO wit. were fd. The Kalkaska Co. peer group approved the above monument as a careful and faithful reestablishment of the position of the original corner.

Ratified by Peer Group  
P.A. 345 - 1990 Kalkaska County  
Chairman *Eugene Farrier*  
Date 12-19-95

C. Description of monument for corner and accessories established to perpetuate locating the position of the corner:

- I-2: Cor. common to Sec. 2 & 3, T26N-R7W, Orange Fd 1/2" R.B. w/cap. Pulled & replaced with 5/8" x 18" R.B. w/brass cap 0.3' below Rd. Surface w/Mon.box.
- Set nail & tag East, P.P., 67.51'
- Set nail & tag S22E, 13" Hemlock, 88.15'
- West, fd. iron w/cap #33969, 33.00'
- Set nail & tag N54W, 15" Maple, 58.98'

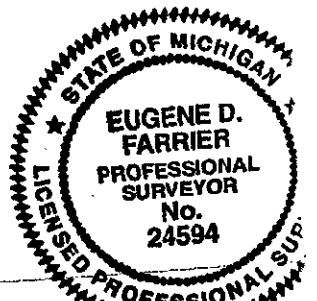

Signed by *Eugene Farrier*

Date 12-22-95

Surveyor's Michigan License No. 24594