

JAN 17 1996

COMMISSION LAND CORNER RECORDATION CERTIFICATE  
Filing Requirement of Act 74, Mich. P.A. 1970

KALKASKA COUNTY, MICHIGAN  
RECEIVED

95 DEC 27 AM 9:55

For corners in

KALKASKA

(County)

Located in:

Corner Code #1

1995 REMONUMENTATION

1. Public Land Survey	T	26N	R	7W	I-5
	T		R		
	T		R		
	T		R		
2. Property Controlling in Section	S		T	R	
	S		T	R	
3. Miscellaneous Property in Sec.	S		T	R	
	S		T	R	

*Jean Hall*  
REG. OF DEEDS

Register of Deeds Stamp & File Number

4. Lot No. \_\_\_\_\_, Recorded Plat \_\_\_\_\_  
5. Private Claims \_\_\_\_\_

A	B	C	D	E	F	G	H	I	J	K	L
2	6	5	4	3	2	1					
3											
4	7	8	9	10	11	12					
5											
6	16	17	16	15	14	13					
7											
8	19	20	21	22	23	24					
9											
10	30	29	28	27	26	25					
11											
12	31	32	33	34	35	36					
13											

I, EUGENE FARRIER, in a field survey on Oct 23, 19 95, do hereby certify that under requirements of P.A. 74, Michigan P.A. of 1970, the corner points mentioned in lines 1 and 2 above were in conformance with regulations and rules therefore as required in the current manual of survey instructions of the United States Department of the Interior, Bureau of Land Management or by a decree of a Court of Law and/or that the corner points mentioned in lines 3, 4 and 5 above were in conformance with the rules of the Michigan Board of Land Surveyors or by a Decree of a Court of Law; established, re-established, monumented, re-monumented, recovered, found as expressed below:

NOTE: Not more than 4 corners, all in the same town and range, may be recorded on this certificate.

A. Description of original monument and accessories and/or subsequent restoration:

I-5: Cor. common to Sec. 10, 11, 14 & 15, T26N-R7W, Orange  
1849 GLO re-survey: set Bech post, Bech 10", S50W, 43; Sgr 15", S65E, 37.  
6-6-1876, D.E.McVee, Co.Surv, HwySurv, used crnr, no accessories.  
11-10-1887, E.Mosher, Co.Surv, HwySurv, used crnr, no accessories.  
8-27-1983, E.D.Farrier, CERT OF SURVEY, fd. 1/2" iron w/cap, L.2 PG.792.  
1-7-1987, LCRC(E.D.Farrier), I-5, fd. 1/2" rod w/cap, L.2 PG.301.

B. Description of corner evidence found and/or method applied in restoring or reestablishing corner:

I-5: Cor. common to Sec. 10, 11, 14 & 15, T26N-R7W, Orange  
Fd iron w/cap #13030 in c/l of Rd. intersection Cool & Saunders Rds.  
Pulled & replaced with 5/8" x 18" R.B. w/brass cap 0.3' below Rd. Surface w/Mon.box. No GLO wit. were fd. The Kalkaska Co. peer group approved the above monument and is accepted as the best available evidence of the position of the original corner.


Ratified by Peer Group  
P.A. 345 - 1990 Kalkaska County

Chairman *Eugene Farrier*

Date 12-19-95

C. Description of monument for corner and accessories established to perpetuate locating the position of the corner:

I-5: Cor. common to Sec. 10, 11, 14 & 15, T26N-R7W, Orange  
Fd iron w/cap #13030. Pulled & replaced with 5/8" x 18" R.B. w/brass cap 0.3' below Rd. Surface w/Mon.box.  
Set nail & tag N45E, 30" Maple, 68.51'  
Set nail & tag S45E, corner fence post, 56.50'  
Set nail & tag S72W, 16" Maple, 65.14'  
Set nail & tag N30W, P.P., 96.74'

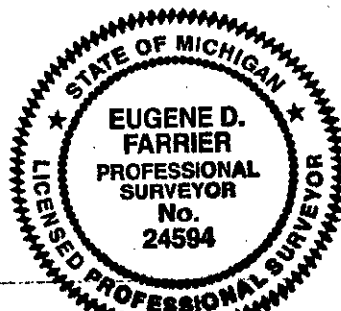

Signed by *Eugene Farrier*

Date 12-22-95

Surveyor's Michigan License No. 24594