

JAN 17 1996

LAND CORNER RECORDATION CERTIFICATE
Filing Requirement of Act 74, Mich. P.A. 1970

KALKASKA COUNTY, MICHIGAN
RECEIVED

95 DEC 27 AM 9:55

Jean Hall
REG. OF DEEDS

For corners in **COMMISSION**

KALKASKA (County)	Located In:	Corner Code #1
1995 REMONUMENTATION		
1. Public Land Survey	T 26N R 7W	0-3
	T R	
	T R	
	T R	
2. Property Controlling in Section	S T R	
	S T R	
3. Miscellaneous Property in Sec.	S T R	
	S T R	

Register of Deeds Stamp & File Number

4. Lot No. _____, Recorded Plat _____
5. Private Claims _____

I, EUGENE FARRIER, in a field survey on Oct. 19, 19 95, do hereby certify that under requirements of P.A. 74, Michigan P.A. of 1970, the corner points mentioned in lines 1 and 2 above were in conformance with regulations and rules therefore as required in the current manual of survey instructions of the United States Department of the Interior, Bureau of Land Management or by a decree of a Court of Law and/or that the corner points mentioned in lines 3, 4 and 5 above were in conformance with the rules of the Michigan Board of Land Surveyors or by a Decree of a Court of Law; established, re-established, monumented, re-monumented, recovered, found as expressed below:

NOTE: Not more than 4 corners, all in the same town and range, may be recorded on this certificate.

	A	B	C	D	E	F	G	H	I	J	K
2	6	5	4	3	2						
3										●	
4	7	8	9	10	11						
5											
6	18	17	16	15	14						
7											
8	19	20	21	22	23						
9											
10	30	29	28	27	26						
11											
12	31	32	33	34	35						
13											

A. Description of original monument and accessories and/or subsequent restoration:

J-3: Cor. common to Sec. 2 & 11, T26N-R7W, Orange
1850 GLO re-survey: set Sgr 1/4 post, Sgr 22", N72W, 9; Bech 9", S45E, 15.
5-6-1987, E.D. Farrier, COS, fd 1 1/2" I.P., Set 1/2" I.R. w/cap in pipe, w/access, L. 3 P. 117.
4-11-1988, E.D. Farrier, CERT OF SURV, fd 1/2" iron rod w/cap, w/access.
8-30-1993, LCRC (E.D. Farrier), J-3, fd. 1 1/2" iron pipe, Set 1/2" iron rod.
5-27-1994, E.D. Farrier, CERT OF SURV, fd 1/2" iron w/cap #24594 w/access..


B. Description of corner evidence found and/or method applied in restoring or reestablishing corner:

J-3: Cor. common to Sec. 2 & 11, T26N-R7W, Orange
Fd 1/2" iron w/cap #24594 in 1 1/2" iron pipe in c/l of Pontius Rd.
Pulled & replaced with 5/8" x 18" R.B. w/brass cap 0.3' below Rd. Surface.
No GLO wit. were fd. The Kalkaska Co. peer group approved the above monument and is accepted as the best available evidence of the position of the original corner.

Ratified by Peer Group
P.A. 345 - 1990 Kalkaska County
Chairman Eugene Farrier
Date 12-19-95

C. Description of monument for corner and accessories established to perpetuate locating the position of the corner:

J-3: Cor. common to Sec. 2 & 11, T26N-R7W, Orange
Fd 1/2" iron w/cap #24594. Pulled & replaced with 5/8" x 18" R.B. w/brass cap 0.3' below Rd. Surface.
Set nail & tag S05E, 14" Maple, 39.08'
Set nail & tag S62W, 20" Maple, 63.33'
Set nail & tag N10W, 7" R. Pine, 69.16'
Set nail & tag N58E, 20" Maple, 45.91'

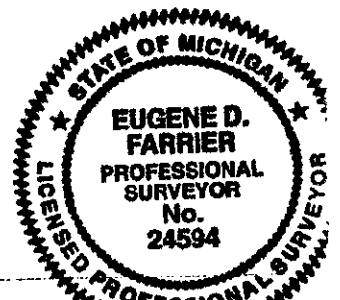

Signed by Eugene Farrier
Surveyor's Michigan License No. 24594

Date 12-22-95