

**SURVEY &
REMONUMENTATION**

MAR 21 1997

COMMISSION

LAND CORNER RECORDATION CERTIFICATE
Filing Requirement of Act 74, Mich. P.A. 1970

KALKASKA COUNTY, MICHIGAN
RECEIVED

97 JAN 31 PM 3:20

Joan Hall
REG. OF DEEDS

For corners in

KALKASKA

(County)

Located In:

Corner Code #/

1996 REMONUMENTATION

- | | | |
|---------------------------------------|--------------------------|------------|
| 1. Public Land Survey | T <u>26N</u> R <u>7W</u> | <u>J-7</u> |
| | T _____ R _____ | _____ |
| | T _____ R _____ | _____ |
| | T _____ R _____ | _____ |
| 2. Property Controlling in Section | S _____ T _____ R _____ | _____ |
| | S _____ T _____ R _____ | _____ |
| 3. Miscellaneous Property in Sec. | S _____ T _____ R _____ | _____ |
| | S _____ T _____ R _____ | _____ |
| 4. Lot No. _____, Recorded Plat _____ | | |
| 5. Private Claims _____ | | |

Register of Deeds Stamp & File Number

I, EUGENE FARRIER, in a field survey on Nov. 21, 19 96, do hereby certify that under requirements of P.A. 74, Michigan P.A. of 1970, the corner points mentioned in lines 1 and 2 above were in conformance with regulations and rules therefore as required in the current manual of survey instructions of the United States Department of the Interior, Bureau of Land Management or by a decree of a Court of Law and/or that the corner points mentioned in lines 3, 4 and 5 above were in conformance with the rules of the Michigan Board of Land Surveyors or by a Decree of a Court of Law; established, re-established, monumented, re-monumented, recovered, found as expressed below:


NOTE: Not more than 4 corners, all in the same town and range, may be recorded on this certificate.

| | A | B | C | D | E | F | G | H | I | J | K | L | M |
|----|----|---|----|---|----|---|----|---|----|---|----|---|---|
| 2 | 6 | | 5 | | 4 | | 3 | | 2 | | | | |
| 3 | | | | | | | | | | | | | |
| 4 | 7 | | 8 | | 9 | | 10 | | 11 | | 12 | | |
| 5 | | | | | | | | | | | | | |
| 6 | 18 | | 17 | | 16 | | 15 | | 14 | | 13 | | |
| 7 | | | | | | | | | | | | | |
| 8 | 19 | | 20 | | 21 | | 22 | | 23 | | 24 | | |
| 9 | | | | | | | | | | | | | |
| 10 | 30 | | 29 | | 28 | | 27 | | 26 | | 25 | | |
| 11 | | | | | | | | | | | | | |
| 12 | 31 | | 32 | | 33 | | 34 | | 35 | | 36 | | |
| 13 | | | | | | | | | | | | | |

- A. Description of original monument and accessories and/or subsequent restoration:
 J-07: Cor. common to Sec. 14 & 23, T26N-R7W, Orange Township
 Jul 18, 1849, GLO resurvey, set Sugar post. 5" Sugar N65E, 13, 6" Sugar S50W, 6.
 Jun 13, 1891, E. Mosher, Co. Surveyor, used cor. no accessories.
 07-17-1975, LCRC Liber 1 pg. 358.
 07-06-1979, J.L. Fletcher, fd Pk & set 1/2" re-rod. Cert. of Survey Liber 2 pg. 370.
 07-17-1979, J.L. Fletcher, fd Pk & set 1/2" re-rod. Cert. of Survey Liber 2 pg. 379.
 05-06-1992, E.D. Farrier, Survey #8192, fd 5/8" iron rod, w/ accessories.
- B. Description of corner evidence found and/or method applied in restoring or reestablishing corner:
 J-07: Cor. common to Sec. 14 & 23, T26N-R7W, Orange Township
 Found 1/2" x 36" re-rod w/ accessories. Pulled & Set 5/8" x 18" re-rod w/ Brass cap in Mon Box in center line of Spencer Rd. No G.L.O. witnesses found. The Kalkaska Co. peer group approved and accepted the above monument as the best available evidence of the position of the original corner.

Ratified by Peer Group
P.A. 345 - 1990 Kalkaska County
 Chairman Eugene Farrier
 Date 1-21-97

- C. Description of monument for corner and accessories established to perpetuate locating the position of the corner:
 J-07: Cor. common to Sec. 14 & 23, T26N-R7W, Orange Township
 Found 1/2" x 36" re-rod w/ accessories. Pulled & Set 5/8" x 18" re-rod w/ Brass cap in Mon Box in center line of Spencer Rd.
 Set nail & tag N42W 14" Maple, 56.55'
 Set nail & tag N55E Power Pole, 47.83'
 Set nail & tag S29E 40" Maple, 53.96'
 Set nail & tag S54W 16" Maple, 40.19'

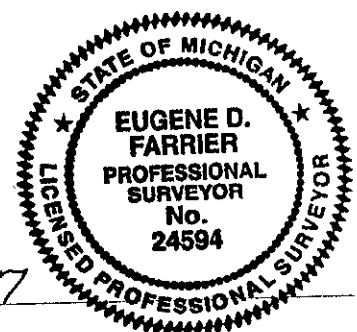

Signed by Eugene Farrier Date 1-30-97
 Surveyor's Michigan License No. 24594