

MAR 01 2000

SECTION

LAND CORNER RECORDATION CERTIFICATE
Filing Requirement of Act 74, Mich. P.A. 1970

For corners in

KALKASKA Located In: Corner Code #
(County)
1999 REMONUMENTATION
1. Public Land Survey T 25N R 7W J-1
T 26N R 7W J-13
T ___ R ___
T ___ R ___
2. Property Controlling S ___ T ___ R ___
in Section S ___ T ___ R ___
3. Miscellaneous S ___ T ___ R ___
Property in Sec. S ___ T ___ R ___



3020183
Page: 1 of 1
02/04/2000 03:40P
REMON
LB: 6 PG: 129

4. Lot No. _____, Recorded Plat _____

5. Private Claims _____

I, EUGENE FARRIER, in a field survey on December 23, 1999 do hereby state that under requirements of P.A. 74, Michigan P.A. of 1970, the corner points mentioned in lines 1 and 2 above were in conformance with regulations and rules therefore as required in the current manual of survey instructions of the United States Department of the Interior, Bureau of Land Management or by a decree of a Court of Law and /or that the corner points mentioned in lines 3, 4 and 5 above were in conformance with the rules of the Michigan Board of Land Surveyors or by a Decree of a Court of Law; established, re-established, monumented, recovered, found as expressed below:

NOTE: Not more than 2 corners, all in the same town and range, may be recorded on this certificate.

	A	B	C	D	E	F	G	H	I	J	K	L	M
1													
2	6		5		4		3		2		1		
3													
4	7		8		9		10		11		12		
5													
6	18		17		16		15		14		13		
7													
8	19		20		21		22		23		24		
9													
10	30		29		28		27		26		25		
11													
12	31		32		33		34		35		36		
13													


A. Description of original monument and accessories and/or subsequent restoration:

J-1: 1/4 Cor. Common to Secs. 2, T25N-R7W, J-13: Sec. 35, T26N-R7W, Garfield Twp
 1853, G.L.O. Resurvey, V.W. Caukin (Deputy Surveyor) Co. Survey Notes, Pg 12, set Beach 1/4 section post, Hemlock 16", N5°W, 23 Lks; Hemlock 24", N45°E, 34 Lks
 1915, Survey, by W.S. Merrill (Co. Surveyor) Co. Survey Bk 11, Pgs 90 & 91, shows corner with distances East & West
 1989, LCRC, by E. Farrier (Co. Surveyor) found 7/8" iron rod, 4' South of centerline of E-W gravel road. Corner falls in line with old fence to North, N35°E, 60.48', 10" R. Pine; S51°E, 76.10', Twin 12" Maple; N05°E, 34.11', power pole; S10°E, 67.70', 6" Maple in clump of 5
 1992, Survey, by E. Farrier (Co. Surveyor), found same as Farrier (1989)
 1997, Survey, by Farrier Surveying, found same as Farrier (1989)

B. Description of corner evidence found and/or method applied in restoring or reestablishing corner:

J-1: 1/4 Cor. Common to Secs. 2, T25N-R7W, J-13: Sec. 35, T26N-R7W, Garfield Twp
 Found 3/4" iron pipe 2' South of centerline of road.
 N05°E, 34.11', power pole, set nail & washer over old nail
 N35°E, 60.46', 12" R. Pine, set nail & washer
 S51°E, 76.10', 12" Twin Maple, found nail
 S10°E, 67.10', 8" Maple in clump, found nail
 South 33.00', iron & cap #24594
 No G.L.O. witnesses were found.

Ratified by Peer Group
 P.A. 345 - 1990 Kalkaska County
 Chairman Eugene Farrier
 Date 02-03-00

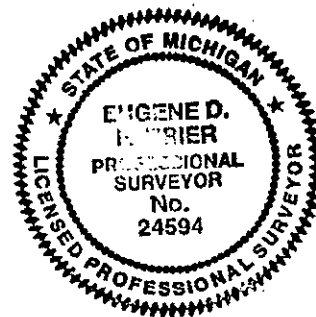

C. Description of monument for corner and accessories established to perpetuate locating the position of the corner:

J-1: 1/4 Cor. Common to Secs. 2, T25N-R7W, J-13: Sec. 35, T26N-R7W, Garfield Twp
 Found 3/4" iron pipe 2' South of centerline of road. Added 5/8" X 18" rerod w/ brass cap.
 N12°E, 24.91', 28" Maple, found nail
 N05°E, 34.11', power pole, set nail & washer over old nail
 N35°E, 60.46', 12" R. Pine, set nail & washer
 S51°E, 76.10', 12" Twin Maple, found nail
 S10°E, 67.10', 8" Maple in clump, found nail
 South 33.00', iron & cap #24594
 Kalkaska County Peer Group accepted the above monument as the best available evidence of the position of the original corner.

Signed by Eugene Farrier Date 02-04-00
 Surveyor's Michigan License No. 24594