

SURVEY & REMONUMENTATION

MAR 21 1997

COMMISSION

KALKASKA COUNTY, MICHIGAN
RECEIVED

LAND CORNER RECORDATION CERTIFICATE
Filing Requirement of Act 74, Mich. P.A. 1970

JAN 31 PH 3: 20

For corners in

KALKASKA
(County)

Located In:

Corner Code ##

1996 REMONUMENTATION

- | | | | | | |
|------------------------------------|---|-----|---|----|-----|
| 1. Public Land Survey | T | 26N | R | 7W | K-6 |
| | T | | R | | |
| | T | | R | | |
| | T | | R | | |
| 2. Property Controlling in Section | S | | T | R | |
| | S | | T | R | |
| 3. Miscellaneous Property in Sec. | S | | T | R | |
| | S | | T | R | |
4. Lot No. _____, Recorded Plat _____
5. Private Claims _____

Jean Hall
REG. DEEDS

Register of Deeds Stamp & File Number

I, EUGENE FARRIER, in a field survey on Nov. 14, 19 96, do hereby certify that under requirements of P.A. 74, Michigan P.A. of 1970, the corner points mentioned in lines 1 and 2 above were in conformance with regulations and rules therefore as required in the current manual of survey instructions of the United States Department of the Interior, Bureau of Land Management or by a decree of a Court of Law and/or that the corner points mentioned in lines 3, 4 and 5 above were in conformance with the rules of the Michigan Board of Land Surveyors or by a Decree of a Court of Law; established, re-established, monumented, re-monumented, recovered, found as expressed below:

A	B	C	D	E	F	G	H	I	J	K	L	M
2	6		5		4		3		2		1	
3												
4	7		8		9		10		11		12	
5												
6	18		17		16		15		14	●	13	
7												
8	19		20		21		22		23		24	
9												
10	30		29		28		27		26		25	
11												
12	31		32		33		34		35		36	
13												


NOTE: Not more than 4 corners, all in the same town and range, may be recorded on this certificate.

A. Description of original monument and accessories and/or subsequent restoration:
 K-06: Cor. common to Sec. 13 & 14, T26N-R7W, Orange Township 1849, GLO resurvey, set Hemlock post. 10"Hemlock N76W 26, 14"Sugar N85E 43.
 Jun 13, 1891, E. Mosher, Co. Surveyor, used cor. no accessories.
 08-07-1978, J.L. Fletcher, 2" O.D. iron pipe, w/ no accessories.
 12-04-1982, E.D. Farrier, Survey #6582, fd 1" iron pipe, w/ accessories.
 May 1990, LCRC Farrier Surveying, fd 1" iron pipe, w/ accessories.

B. Description of corner evidence found and/or method applied in restoring or reestablishing corner:
 K-06: Cor. common to Sec. 13 & 14, T26N-R7W, Orange Township Found 1 1/4" x 36" Well Point w/ accessories. Pulled & Set 5/8" x 18" re-rod w/ Brass cap 3' East of centerline Golden Rd. No G.L.O. witnesses found. The Kalkaska Co. peer group approved and accepted the above monument as the best available evidence of the position of the original corner.

Ratified by Peer Group
 P.A. 345 - 1990 Kalkaska County
 Chairman Eugene Farrier
 Date 1-21-97

C. Description of monument for corner and accessories established to perpetuate locating the position of the corner:
 K-06: Cor. common to Sec. 13 & 14, T26N-R7W, Orange Township Found 1 1/4" x 36" Well Point w/ accessories. Pulled & Set 5/8" x 18" re-rod w/ Brass cap 3' East of centerline Golden Rd.
 Set nail & tag S82W 24" Hemlock, 35.55' (old witness)
 Set nail & tag N45W 10" Maple, 50.48' (old witness)
 Set nail & tag N57E 14" R.Pine, 52.54' (old witness)
 Set nail & tag S35E 12" Poplar, 53.10' (old witness)

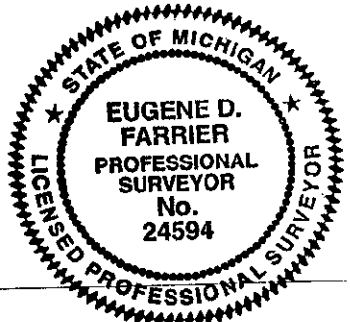

Signed by Eugene Farrier Date 1-30-97
 Surveyor's Michigan License No. 24594