

MAR 21 1997

COMMISSION

KALKASKA COUNTY, MICHIGAN  
RECEIVED

**LAND CORNER RECORDATION CERTIFICATE** JAN 31 PM 3:20  
Filing Requirement of Act 74, Mich. P.A. 1970

For corners in

<u>KALKASKA</u> (County)	Located In:	Corner Code #
1996 REMONUMENTATION		
1. Public Land Survey	T <u>26N</u> R <u>7W</u>	<u>L-3</u>
	T _____ R _____	_____
	T _____ R _____	_____
	T _____ R _____	_____
2. Property Controlling in Section	S _____ T _____ R _____	_____
	S _____ T _____ R _____	_____
3. Miscellaneous Property in Sec.	S _____ T _____ R _____	_____
	S _____ T _____ R _____	_____
4. Lot No. _____, Recorded Plat _____		
5. Private Claims _____		

*Jean Hall*  
REG. OF DEEDS

Register of Deeds Stamp & File Number

I, EUGENE FARRIER, in a field survey on \_\_\_\_\_, 19 96, do hereby certify that under requirements of P.A. 74, Michigan P.A. of 1970, the corner points mentioned in lines 1 and 2 above were in conformance with regulations and rules therefore as required in the current manual of survey instructions of the United States Department of the Interior, Bureau of Land Management or by a decree of a Court of Law and/or that the corner points mentioned in lines 3, 4 and 5 above were in conformance with the rules of the Michigan Board of Land Surveyors or by a Decree of a Court of Law; established, re-established, monumented, re-monumented, recovered, found as expressed below:

**NOTE: Not more than 4 corners, all in the same town and range, may be recorded on this certificate.**

A	B	C	D	E	F	G	H	I	J	K	L	M
2	6	5	4	3	2	1						
3												
4	7	8	9	10	11	12						
5												
6	18	17	16	15	14	13						
7												
8	19	20	21	22	23	24						
9												
10	30	29	28	27	26	25						
11												
12	31	32	33	34	35	36						
13												

A. Description of original monument and accessories and/or subsequent restoration:

L-03: Cor. common to Sec. 1 & 12, T26N-R7W, Orange Township  
1849, GLO resurvey, set Cedar post, 7" Cedar N45E, 26.43" Tamarack S43W, 25.  
07-15-1901, W.S. Merrill, used corner, no accessories.  
11-10-1972, LCRC Liber 1 pg. 183.  
11-10-1972, C.F. Roser, set D.N.R. Mon., w/ accessories.

B. Description of corner evidence found and/or method applied in restoring or reestablishing corner:

L-03: Cor. common to Sec. 1 & 12, T26N-R7W, Orange Township  
Found DNR Mon w/ 3" x 3" Cedar Post w/ accessories. No G.L.O. witnesses found. The Kalkaska Co. peer group approved & accepted the above monument as the best available evidence of the position of the original corner.


Ratified by Peer Group  
P.A. 345 - 1990 Kalkaska County

Chairman Eugene Farrier

Date 1-21-97

C. Description of monument for corner and accessories established to perpetuate locating the position of the corner:

L-03: Cor. common to Sec. 1 & 12, T26N-R7W, Orange Township  
Found DNR Mon w/ 3" x 3" Cedar Post w/ accessories.  
Set nail & tag N25E 4" Cedar, 27.20'  
Set nail & tag N75E 5" Cedar, 32.67'  
Set nail & tag N80W 6" Cedar, 45.07'  
Set nail & tag N40W 5" Balsam Fir, 13.00'

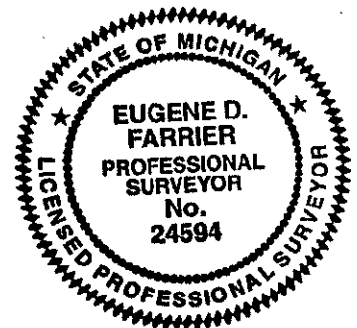

Signed by Eugene Farrier Date 1-21-97  
Surveyor's Michigan License No. 24594