

# SURVEY & REMONUMENTATION

MAR 21 1997

COMMISSION

**LAND CORNER RECORDATION CERTIFICATE**  
Filing Requirement of Act 74, Mich. P.A. 1970

KALKASKA COUNTY, MICHIGAN  
RECEIVED

97 JAN 31 PM 3:20

For corners in

KALKASKA  
(County)

Located In:

Corner Code ##

1996 REMONUMENTATION

- |                                    |                          |       |  |
|------------------------------------|--------------------------|-------|--|
| 1. Public Land Survey              | T <u>26N</u> R <u>7W</u> | L-5   |  |
|                                    | T _____ R _____          | _____ |  |
|                                    | T _____ R _____          | _____ |  |
|                                    | T _____ R _____          | _____ |  |
| 2. Property Controlling in Section | S _____ T _____ R _____  | _____ |  |
|                                    | S _____ T _____ R _____  | _____ |  |
| 3. Miscellaneous Property in Sec.  | S _____ T _____ R _____  | _____ |  |
|                                    | S _____ T _____ R _____  | _____ |  |
4. Lot No. \_\_\_\_\_, Recorded Plat \_\_\_\_\_
5. Private Claims \_\_\_\_\_

*Jean Hall*  
REG. OF DEEDS

Register of Deeds Stamp & File Number

I, EUGENE FARRIER, in a field survey on Oct. 1, 19 96, do hereby certify that under requirements of P.A. 74, Michigan P.A. of 1970, the corner points mentioned in lines 1 and 2 above were in conformance with regulations and rules therefore as required in the current manual of survey instructions of the United States Department of the Interior, Bureau of Land Management or by a decree of a Court of Law and/or that the corner points mentioned in lines 3, 4 and 5 above were in conformance with the rules of the Michigan Board of Land Surveyors or by a Decree of a Court of Law; established, re-established, monumented, re-monumented, recovered, found as expressed below:

**NOTE: Not more than 4 corners, all in the same town and range, may be recorded on this certificate.**

A	B	C	D	E	F	G	H	I	J	K	L	M
2	6	5	4	3	2	1						
3												
4	7	8	9	10	11	12						
5												
6	18	17	16	15	14	13						
7												
8	19	20	21	22	23	24						
9												
10	30	29	28	27	26	25						
11												
12	31	32	33	34	35	36						
13												

A. Description of original monument and accessories and/or subsequent restoration:

L-05: Cor. common to Sec. 12 & 13, T26N-R7W, Orange Township  
1849, GLO resurvey, set Hemlock post, 6" Birch N19W 13, 10" B. Ash S5E 37.  
07-15-1901, W.S. Merrill, set Cedar Post, Birch stump of Gov. Bearing Tree, 26" Pine stump S75E 22.5.  
12-03-1982, Farrier Surveying, fd 3/4" x 2.5" iron bar w/ stake (old), no accessories.  
May 1990, LCRC Liber ? pg.?, fd 1/2" x 2.5" iron, w/ accessories.  
06-18-1990, E.D. Farrier, Survey #23089, fd 1/2" x 2.5" iron, w/ accessories.  
11-04-1992, E.D. Farrier, Survey #22792, fd 1/2" x 2.5" iron, w/ accessories.

B. Description of corner evidence found and/or method applied in restoring or reestablishing corner:


L-05: Cor. common to Sec. 12 & 13, T26N-R7W, Orange Township  
Found 1/2" x 2 1/2" x 12" iron bar next to 3" x 3" Cedar Stake w/ accessories. Pulled & Set 5/8" x 18" re-rod w/ Brass cap in centerline of Cool Road. No G.L.O. witnesses were found. Old Cedar stake appears to be same Cedar stake set by Merrill (1901). The Kalkaska Co. peer group approved & accepted the above monument as a careful and faithful perpetuation of the position of the original corner.

**Ratified by Peer Group**  
**P.A. 345 - 1990 Kalkaska County**

Chairman Eugene Farrier  
Date 1-21-97

C. Description of monument for corner and accessories established to perpetuate locating the position of the corner:

L-05: Cor. common to Sec. 12 & 13, T26N-R7W, Orange Township  
Found 1/2" x 2 1/2" x 12" iron bar next to 3" x 3" Cedar Stake w/ accessories. Pulled & Set 5/8" x 18" re-rod w/ Brass cap in centerline of Cool Road.  
North iron & cap #24594, 33.00'.  
Fd nail N68E Power Pole, 82.86'.  
Set nail & tag S43E 6" Cedar, 50.08'.  
Set nail & tag S28W 7" Maple, 42.97'.

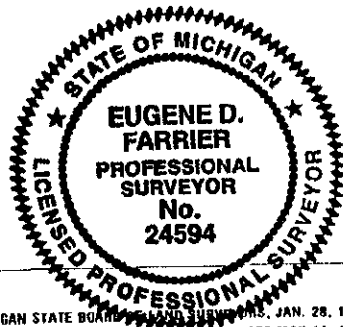

Signed by Eugene Farrier  
Surveyor's Michigan License No. 24594

Date 1-30-97