

SURVEY & REMONUMENTATION

MAR 21 1997

COMMISSION

KALKASKA COUNTY, MICHIGAN RECEIVED

97 JAN 31 PM 2: 26

LAND CORNER RECORDATION CERTIFICATE
Filing Requirement of Act 74, Mich. P.A. 1970

Joan Hall
 REG. OF DEEDS

For corners in

KALKASKA
 (County)

Located In:

Corner Code #:

1996 REMONUMENTATION

1. Public Land Survey

T 26N R 6W

T 26N R 7W

T _____ R _____

T _____ R _____

A-4

2. Property Controlling in Section

S _____ T _____ R _____

S _____ T _____ R _____

3. Miscellaneous Property in Sec.

S _____ T _____ R _____

S _____ T _____ R _____

Register of Deeds Stamp & File Number

1. Lot No. _____, Recorded Plat _____

2. Private Claims _____

| | A | B | C | D | E | F | G | H | I | J | K | L | M |
|----|----|----|----|----|----|----|---|---|---|---|---|---|---|
| 2 | 6 | 5 | 4 | 3 | 2 | 1 | | | | | | | |
| 3 | | | | | | | | | | | | | |
| 4 | 7 | 8 | 9 | 10 | 11 | 12 | | | | | | | |
| 5 | | | | | | | | | | | | | |
| 6 | 18 | 17 | 16 | 15 | 14 | 13 | | | | | | | |
| 7 | | | | | | | | | | | | | |
| 8 | 19 | 20 | 21 | 22 | 23 | 24 | | | | | | | |
| 9 | | | | | | | | | | | | | |
| 10 | 30 | 29 | 28 | 27 | 26 | 25 | | | | | | | |
| 11 | | | | | | | | | | | | | |
| 12 | 31 | 32 | 33 | 34 | 35 | 36 | | | | | | | |
| 13 | | | | | | | | | | | | | |

EUGENE FARRIER, in a field survey on June 27, 19 96,

do hereby certify that under requirements of P.A. 74, Michigan P.A. of 1970, the corner points mentioned in lines 1 and 2 above were in conformance with regulations and rules therefore as required in the current manual of survey instructions of the United States Department of the Interior, Bureau of Land Management or by a decree of a Court of Law and/or that the corner points mentioned in lines 3, 4 and 5 above were in conformance with the rules of the Michigan Board of Land Surveyors or by a Decree of a Court of Law; established, re-established, monumented, re-monumented, recovered, found as expressed below:

NOTE: Not more than 4 corners, all in the same town and range, may be recorded on this certificate.

Description of original monument and accessories and/or subsequent restoration:

A-04: Cor. comn to Sec. 7, T26N-R6W, Oliver Township, & Sec. 12, T26N-R7W, Orange Township
 Apr 7, 1839, GLO original survey, set post, T26N-R7W. 10"Hemlock S30W 13, 8"Hemlock N43W 29.
 07-15-1901, W.S.Merrill, used corner, no accessories.
 04-17-1911, W.S.Merrill, used corner, no accessories.

Description of corner evidence found and/or method applied in restoring or reestablishing corner:

A-04: Cor. comn to Sec. 7, T26N-R6W, Oliver Township, & Sec. 12, T26N-R7W, Orange Township
 No occupation found except corner fence post w/ accessories. Set 5/8" x 36" re-rod w/ Alum. cap. M.P.O.L. between SW & NW Corners of Sec. 7. No G.L.O. witnesses were found. The Kalkaska Co. peer group approved & accepted the above monument as a careful and faithful reestablishment of the position of the original corner.

Ratified by Peer Group
 P.A. 345 - 1990 Kalkaska County


Chairman Eugene Farrier
 Date 1-21-97

Description of monument for corner and accessories established to perpetuate locating the position of the corner:

A-04: Cor. comn to Sec. 7, T26N-R6W, Oliver Township, & Sec. 12, T26N-R7W, Orange Township
 No occupation found except corner fence post w/ accessories. Set 5/8" x 36" re-rod w/ Alum. cap. M.P.O.L. between SW & NW Corners of Sec. 7.
 Set nail & tag S38E 3" Cherry, 14.78'.
 Set nail & tag S15W 3" Cherry, 30.50'.
 Set nail & tag N08W 16" W. Pine, 24.01'.
 Set nail & tag N45E 4" Cherry 45.10'.
 South corner post, 33.00'.

signed by Eugene Farrier
 Surveyor's Michigan License No. 24594

1-30-97
 Date

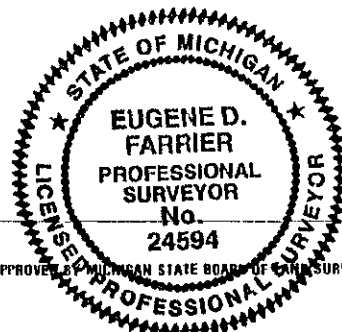

FORM APPROVED BY MICHIGAN STATE BOARD OF LAND SURVEYORS, JAN. 28, 1971
 REVISED MAY 14, 1975
 REVISED JAN., 1983