

SURVEY & REMONUMENTATION

MAR 21 1997

COMMISSION

KALKASKA COUNTY, MICHIGAN
RECEIVED

LAND CORNER RECORDATION CERTIFICATE 97 JAN 31 PH 2:26
Filing Requirement of Act 74, Mich. P.A. 1970

Jean Hall
REG. DEEDS

For corners in

KALKASKA

(County)

Located In:

Corner Code #

1996 REMONUMENTATION
Public Land Survey

T 26N R 6W

T 26N R 7W

A-5



T R

T R

S T R

S T R

S T R

S T R

Register of Deeds Stamp & File Number

Lot No. _____, Recorded Plat _____
Private Claims _____

	A	B	C	D	E	F	G	H	I	J	K	L	M
2	6	5	4	3	2	1							
3													
4	7	8	9	10	11	12							
5													
6	18	17	16	15	14	13							
7													
8	19	20	21	22	23	24							
9													
10	30	29	28	27	26	25							
11													
12	31	32	33	34	35	36							
13													

EUGENE FARRIER, in a field survey on Nov. 14, 1996

do hereby certify that under requirements of P.A. 74, Michigan P.A. of 1970, the corner points mentioned in lines 1 and 2 above were in conformance with regulations and rules therefore as required in the current manual of survey instructions of the United States Department of the Interior, Bureau of Land Management or by a decree of a Court of Law and/or that the corner points mentioned in lines 3, 4 and 5 above were in conformance with the rules of the Michigan Board of Land Surveyors or by a Decree of a Court of Law; established, re-established, monumented, re-monumented, recovered, found as expressed below:

NOTE: Not more than 4 corners, all in the same town and range, may be recorded on this certificate.

Description of original monument and accessories and/or subsequent restoration:

- A-05: Cor. comn to Sec. 7 & 18, T26N-R6W, Oliver Township & Sec. 12 & 13, T26N-R7W, Orange Township.
- GLO, set post, T26N-R7W. 18" Sugar S23W 26, 10" Hemlock N40W 23.
- GLO, set post, T26N-R6W. 9" Beech S15E 36, 12" Hemlock N46E 15.
- May 1882, E.Mosher, used corner, no accessories.
- 1894, E.Mosher, used corner, no accessories.
- 07-15-1901, W.S.Merrill, established pro. dist., 28" Maple S60E 52.5, Cedar stake.
- 08-29-1904, W.S.Merrill, fd. iron stake, no accessories.
- 04-17-1911, W.S.Merrill, used corner, no accessories.
- 08-28-1975, J.L.Fletcher, used corner, no accessories.
- 06-03-1988, Farrier Surveying, Survey #8388, fd 2" pipe, w/ accessories.
- 07-10-1988, LCRC Liber 2 pg. 382.
- May 1990, LCRC Liber ? pg. ? fd 2" pipe w/ cap#30079 w/ accessories.
- 06-18-1990, E.D.Farrier, Survey #23089, used corner w/ accessories.

Description of corner evidence found and/or method applied in restoring or reestablishing corner:

- A-05: Cor. comn to Sec. 7 & 18, T26N-R6W, Oliver Township & Sec. 12 & 13, T26N-R7W, Orange Township.
- Found 1/2" re-rod w/ cap #30079 and 2" x 18" Iron Pipe w/ accessories.
- Pulled & Set 5/8" x 18" re-rod w/ Brass cap in centerline of intersection of Cool road & Pierson Road to South. No G.L.O. witnesses fd. The Kalkaska Co. peer group approved & accepted the above monument as the best available evidence of the position of the original corner.

Description of monument for corner and accessories established to perpetuate locating the position of the corner:

- A-05: Cor. comn to Sec. 7 & 18, T26N-R6W, Oliver Township & Sec. 12 & 13, T26N-R7W, Orange Township.
- Found 1/2" re-rod w/ cap #30079 and 2" x 18" Iron Pipe w/ accessories.
- Pulled & Set 5/8" x 18" re-rod w/ Brass cap in centerline of intersection of Cool road & Pierson Road to South.
- Set nail & tag N38W 6" Wood Post (AT&T), 69.40'
- Set nail & tag N10W Power Pole, 44.80'
- Set nail & tag S50E 6" Wood Post (AT&T), 54.06'
- Set nail & tag S35W 5" R.Pine, 69.55'


Ratified by Peer Group
P.A. 345 - 1990 Kalkaska County

Chairman *Eugene Farrier*

Date *1-21-97* Date *1-30-97*

Signed by *Eugene Farrier*

Surveyor's Michigan License No. *24594*

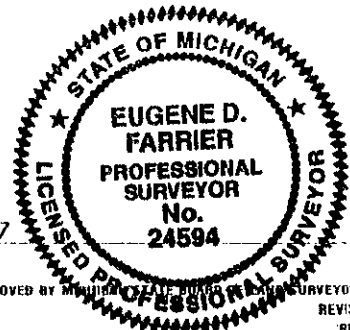

FORM APPROVED BY MICHIGAN STATE BOARD OF LAND SURVEYORS, JAN. 28, 1971
REVISED MAY 14, 1975
REVISED JAN., 1983