

LAND CORNER RECORDATION CERTIFICATE
Filing Requirement of Act 74, Mich. P.A. 1970

For corners in

<u>KALKASKA</u> (County)	Located In:	Corner Code <u>##</u>
1. Public Land Survey	T <u>26N</u> R <u>7W</u>	<u>C-3</u>
	T _____ R _____	_____
	T _____ R _____	_____
	T _____ R _____	_____
2. Property Controlling in Section	S _____ T _____ R _____	_____
	S _____ T _____ R _____	_____
3. Miscellaneous Property in Sec.	S _____ T _____ R _____	_____
	S _____ T _____ R _____	_____

Register of Deeds Stamp & File Number

4. Lot No. _____, Recorded Plat _____
 5. Private Claims _____

A	B	C	D	E	F	G	H	I	J	K	L	M
2	6	5	4	3	2	1						
3		●										
4	7	8	9	10	11	12						
5												
6	18	17	16	15	14	13						
7												
8	19	20	21	22	23	24						
9												
10	30	29	28	27	26	25						
11												
12	31	32	33	34	35	36						
13												

I, CARL F. ROSER, in a field survey on MAY 12, 1987, 19____, do hereby certify that under requirements of P.A. 74, Michigan P.A. of 1970, the corner points mentioned in lines 1 and 2 above were in conformance with regulations and rules therefore as required in the current manual of survey instructions of the United States Department of the Interior, Bureau of Land Management or by a decree of a Court of Law and/or that the corner points mentioned in lines 3, 4 and 5 above were in conformance with the rules of the Michigan Board of Land Surveyors or by a Decree of a Court of Law; established, re-established, monumented, re-monumented, recovered, found as expressed below:

NOTE: Not more than 4 corners, all in the same town and range, may be recorded on this certificate.

~~B. CONTINUED: Description of original monument and accessories and/or subsequent restoration.~~

C-3 (CONTINUED) BY FLETCHER BACK IN 1978 WHILE WORKING FOR GRANGER ENGR.) ALSO G. SHADKO (DEPT. SURVEYOR-NOW DECEASED) SURVEYED SEC 7 IN 1946 & SUBDIVIDED SEC 7 FOR STATE-OWNED NE-SE SEC 7; HIS NOTES (BK 14, PGS 71-90) INDICATING HE FD A 1" PIPE IN RD INTERSEC E-W-N FOR NE SEC 7; RD IS NOW B.TOP AND IN PIPE IS GONE, BUT HIS MEASUREMENTS FIT OURS TO FOUND CAST IRON 20" DEEP.


B. Description of corner evidence found and/or method applied in restoring or reestablishing corner:

C-3 FD 3/4" X 2-1/2" X 18" PIECE OF CAST IRON (VERTICAL) BURIED 20"; TOP 5" BROKE OFF WHILE DIGGING FOR COR. COR IS 2'± WEST OF OLD N-S FN. (W-W ON CED POSTS MOSTLY DOWN) LOOKING SOUTH & 3'± NORTH OF E-W B.TOP RD. (B.TOP RD BECOMES GRAVEL RD 8'± WEST.) ALSO FD FOUR 3" TO 6" DIA ROCKS AROUND FD IRON. IT SHOULD BE NOTED THAT THIS E-W CO. RD. WAS FORMERLY ON THE OLDER TWP RD SYSTEM THERE BEING RECORDS OF SURVEYS FOR TWP RD ALONG THE SOUTH LINE OF SECTIONS 5 & 6 IN LARGE, THIN, FLAT LIBER 1 (WITH BLACK COVER) OF COUNTY SURVEYOR'S RECORDS AT REGISTER OF DEEDS; ON PAGES 23 & 24, DATED 1876 & 1881. THE PRESENT ROAD ALIGNMENT WITH R.O.W. FENCES IS VERY DEFINITE AND THIS OLD "OCCUPANCY" RELATES BACK TO GOV'T COR & SEC LINE LOCATION PER ORIGINAL 1849 G.L.O. SUR. RLS #19830, JIM FLETCHER (NO LONGER IN AREA), SET A 3/4" PIPE BY SOME METHOD OF PRORATING, SAID COR BEING N04°31'E, 12,82' (THIS COR IS WAY OFF FOR LAT. REGARDS OCCUPANCY & RECORDS FROM OLD TWP RD SURVEYS). AN IRON WAS ALSO FOUND IN VICINITY OF N 1/4 COR OF SEC. 8, IN LINE WITH FN SOUTH, BUT ON N EDGE OF E-W B.TOP RD. (SAID IRON BELIEVED TO HAVE ALSO BEEN SET

C. Description of monument for corner and accessories established to perpetuate locating the position of the corner:

C-3
 FD 3/4" X 2 1/2" X 12 1/2" CAST IRON, 20" DEEP RAISED WITH 5/8" X 34" REROD W/RLS CAP.

POWER POLE	N83°E	181.89
2" ASH	S20°E	35.95
POWER POLE	S74°W	142.15
CTR B.TOP EAST	SOUTH	3.5'±

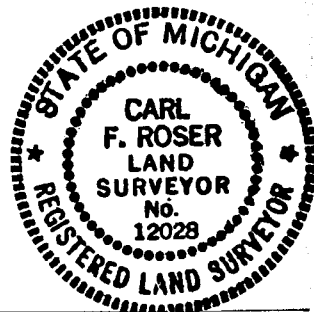

Signed by _____ Date _____

Surveyor's Michigan License No. 12028