LAND CORNER RECORDATION CERTIFICATE

Filing Requirement of Act 74, Mich. P.A. 1970

For corners in

Kalkaska (County)

	Located In:	Corner Code ##
1. Public Land Survey	T 26N R 7W	B-3
	T ___ R ___	
	T ___ R ___	
	T ___ R ___	
2. Property Controlling	S 6 T 26N R 7W	14
in Section	S 6 T 26N R 7W	13
3. Miscellaneous	S ___ T ___ R ___	
Property in Sec.	S ___ T ___ R ___	

Register of Deeds Stamp & File Number

4. Lot No. _____, Recorded Plat _____
5. Private Claims _____

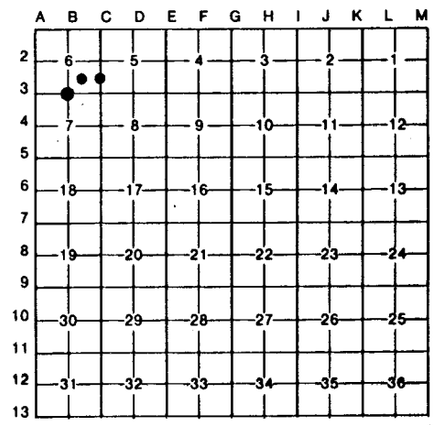

I, Carl F. Roser, in a field survey on May 13, 19 87, do hereby certify that under requirements of P.A. 74, Michigan P.A. of 1970, the corner points mentioned in lines 1 and 2 above were in conformance with regulations and rules therefore as required in the current manual of survey instructions of the United States Department of the Interior, Bureau of Land Management or by a decree of a Court of Law and/or that the corner points mentioned in lines 3, 4 and 5 above were in conformance with the rules of the Michigan Board of Land Surveyors or by a Decree of a Court of Law; established, re-established, monumented, re-monumented, recovered, found as expressed below:

NOTE: Not more than 4 corners, all in the same town and range, may be recorded on this certificate.

C. Continued:

~~Description of original monument and accessories and/or subsequent restoration~~:

13

Drove 5/8" x 34" rerod w/RLS cap &
set cedar post w/loc tag

8" Ash	N85°W	29.8'
13" Maple	N12°E	31.2'
18" Maple	N74°E	39.4'

B. Description of corner evidence found and/or method applied in restoring or reestablishing corner:

B-3 - Restored S¼ corner of Section 6 in line with N-S fence remains to north & in approx. ctr. of E-W gravel road. This fits 1876 hwy. survey along south side of Section 6 by McBain (see large, thin, black cover-Surveyors Record No.1 at Reg. of Deeds) & measurement of N-S ¼ line of Section 6 by W.S. Merrill in 1902 (see Merrill's Bk. of G.L.O. notes - back of Bk., pags. 66 & 67). G. Shadko (Dept. surveyor - now deceased), surveyed Section 7 in 1946 & subdivided Section 7 for state-owned NE-SE Section 7; his notes (Bk. 14, pgs. 71 to 90) indicating he used N¼ corner of Section 5 position of ctr. of E-W road, in line with N&S fences.

14 - Established SE corner of NE¼ - SE¼ of Section 6 per standard B.L.M. instructions. Found 1" sq. x 12" pointed iron, S01°43'E, 6.3'. Corner falls at east edge of N-S sand trail road.

13 - Established the ctr. of the SE¼ of Section 6 per standard B.L.M. instructions. Corner is within 2'± of old E-W fence, all down, hard to find post bottoms. Old fence corner, fn. remains E & S, is West, 161'±.

C. Description of monument for corner and accessories established to perpetuate locating the position of the corner:

B-3

Drove 5/8" x 34" rerod w/RLS cap

7" Maple	N40°W	33.8'
5" White Pine	N32°E	57.3'
13" Maple	S54°E	52.4'
9" Cedar	S46°W	58.1'
Set cedar post w/loc tag	North	33'

14

Drove 5/8" x 34" rerod w/RLS cap

3" Maple	N60°W	27.7'
7" Maple	N66°E	35.0'
6" Maple	S60°E	35.4'
Set cedar post w/loc tag	East	16.5'

STATE OF MICHIGAN
CARL F. ROSER
LAND SURVEYOR
No. 12028
REGISTERED LAND SURVEYOR

Signed by Carl F. Roser 8-20-87 Date _____

Surveyor's Michigan License No. 12028

FORM APPROVED BY MICHIGAN STATE BOARD OF LAND SURVEYORS, JAN. 28, 1971
REVISED MAY 14, 1975
REVISED JAN., 1983