

LAND CORNER RECORDATION CERTIFICATE

FILING REQUIREMENT OF ACT 74, MICH. P.A.1970

FOR CORNERS OF--	LOCATED IN--	CORNER CODE NUMBER
1. PUBLIC LAND SURVEY _____	T. 26 ^{N.} [●] , R. 7 ^{W.} [●]	E-11; F-11; G-11
2. PROPERTY CONTROLLING IN SECTION <u>28</u>	T. 26 ^{N.} [●] , R. 7 ^{W.} [●]	15
3. MISCELLANEOUS PROPERTY IN SECTION _____	T. _____ ^{N.} [●] , R. _____ ^{E.} [●]	_____
4. LOT NO. _____	RECORDED PLAT _____	
5. PRIVATE CLAIMS _____		

REGISTER OF DEEDS STAMP AND FILING NUMBER

I, Carl F. Roser, do hereby certify that under requirements of P.A. 74, Michigan P.A. of 1970, the corner points mentioned in lines 1 and 2 above were, in a field survey on October 20, 1976, established, re-established, monumented, re-monumented, recovered or restored as expressed below and in conformance with regulations and rules therefore as required in the current manual of survey instructions of the United States Department of the Interior, Bureau of Land Management or by a decree of a court of law. Furthermore, that the corner points mentioned in lines 3, 4 and 5 above were, in a field survey on _____, 19____, found, recovered, restored, established or re-established as expressed below and in conformance with the rules of the Michigan State Board of Registration for Land Surveyors or, by a Decree of a Court of law:

A. - ~~Description of original monument and accessories and/or subsequent restoration~~

C. (continued)

15		
Drove 5/8"x36" rerod w/plastic DNR cap & cedar post w/loc. tag		
3" Maple	N47°W	20.90
7" Oak	S79°W	62.80
9" Twn. Oak	S22°W	68.80
Fd. 1/2" Iron	N17°E	1.32

B. Description of corner evidence found and/or method applied in restoring or re-establishing corner:

- E-11 Fd. 1 1/2" pipe as fd. & accepted by RLS #16939 in cert. survey. Same corner as recovered by MSHD in 1946. There is an angle error on MSHD plan sheet, in tie to corner, looks like angle booked in wrong quad.
- F-11 Found and accepted 1/2" rerod by RLS #16939 (certificate survey).
- G-11 Found and accepted concrete monument by RLS #16939 (certificate survey).
- 15 Established 1/16 corner equidistant and on line between found SW & S 1/4 corner Sec. 28.

C. Description of monument for corner and accessories established to perpetuate locating the position of the corner:

E-11	F-11	G-11
Fd. 1 1/2" pipe & set cedar post w/loc. tag	Fd. 1/2"x16" rerod & added DNR mon. & cedar post	Fd. conc. mon. & set cedar post w/loc. tag
6" Maple S72°E 54.23	8" Twn. Maple S08°W 15.12	22" Oak N33°E 40.09
10" Maple N68°E 30.13	5" Ironwood S84°W 32.76	9" Twn. Maple N08°W 37.80
10" Hemlock N27°E 58.05	6" Maple N61°W 20.28	5" Maple S89°W 45.15
8" Hemlock N05°W 69.50	9" Maple N17°E 43.87	6" Maple N86°W 18.9
Ctr. M-66 S84°W 215'±		6" Maple N18°E 11.2
		N. Wheel Track of E-W trail Due S 5'

SIGNED BY Carl F. Roser

DATE 10-31-77

SURVEYOR'S MICHIGAN REGISTRATION NO. 12028


FOR STATE AND UNITED STATES AGENCIES:

SIGNED BY _____
CHIEF OF SURVEY PARTY

DATE _____

APPROVED AND SIGNED BY _____
MICHIGAN REGISTERED LAND SURVEYOR

DATE _____

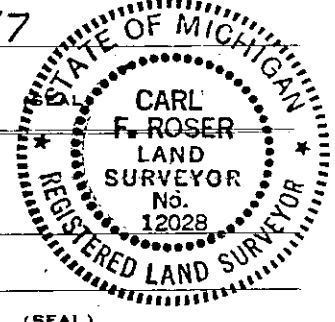

SURVEYOR'S MICHIGAN REGISTRATION NO. _____

ORANGE TOWNSHIP
KALKASKA COUNTY