

LAND CORNER RECORDATION CERTIFICATE

FILING REQUIREMENT OF ACT 74, MICH. P.A.1970

FOR CORNERS OF--:	LOCATED IN--:	CORNER CODE NUMBER
1. PUBLIC LAND SURVEY _____ T. _____	N. _____ S., R. _____ E. _____ W. _____	_____
2. PROPERTY CONTROLLING IN SECTION <u>28</u>	T. <u>26</u> N. _____ S., R. <u>7</u> E. _____ W. _____	<u>9; 10; 11</u>
3. MISCELLANEOUS PROPERTY IN SECTION _____	T. _____ N. _____ S., R. _____ E. _____ W. _____	_____
4. LOT NO. _____, RECORDED PLAT _____		
5. PRIVATE CLAIMS _____		

REGISTER OF DEEDS STAMP AND FILING NUMBER

I, Carl F. Roser, do hereby certify that under requirements of P.A. 74, Michigan P.A. of 1970, the corner points mentioned in lines 1 and 2 above were, in a field survey on October 20, 1976, established, re-established, monumented, re-monumented, recovered or restored as expressed below and in conformance with regulations and rules therefore as required in the current manual of survey instructions of the United States Department of the Interior, Bureau of Land Management or by a decree of a court of law. Furthermore, that the corner points mentioned in lines 3, 4 and 5 above were, in a field survey on _____, 19____, found, recovered, restored, established or re-established as expressed below and in conformance with the rules of the Michigan State Board of Registration for Land Surveyors or, by a Decree of a Court of law:

A. Description of original monument and accessories and/or subsequent restoration:

B. Description of corner evidence found and/or method applied in restoring or re-establishing corner:


- 9 Established 1/16 corner equidistant & on line between Center & E $\frac{1}{4}$ corner of Sec. 28. New gate in old fence is 50'± W & 4'± S of 1/16 corner as of October 1976.
- 10 Established 1/16 corner equidistant & on line between comp. position for W $\frac{1}{4}$ Sec. 28 (in lake) on found SW corner Sec. 28.
- 11 Established center of SW $\frac{1}{4}$ of Sec. 28 per standard B.L.M. instructions, based on controlling corners around entire Sec. 28.

C. Description of monument for corner and accessories established to perpetuate locating the position of the corner:

9	10	11
Drove 5/8"x36" rerod w/plastic DNR cap & ced.post w/loc. tag	Drove 5/8"x36" rerod w/plastic DNR cap & ced. post w/loc.tag	Drove 5/8"x36" rerod w/plastic DNR cap & ced.post w/loc. tag
18" Twn.Oak N72°E 59.82	16" Oak N57°W 7.50	10" Oak N20°E 46.18
10" Oak N06°E 101.80	6" Oak N52°E 36.08	14" R. Pine S50°E 40.35
12" Maple N80°W 81.17	12" Oak S63°E 43.45	18" R. Pine S12°W 47.26
30" Oak S36°W 55.55	Ctr. M-66 Due W 326.6±	
E-W fence remains Due S 3'		

SIGNED BY Carl F. Roser
 SURVEYOR'S MICHIGAN REGISTRATION NO. 12028

DATE 10-31-77

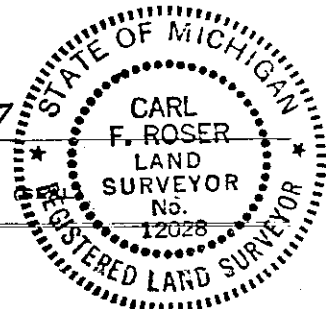

FOR STATE AND UNITED STATES AGENCIES:

SIGNED BY _____ DATE _____
CHIEF OF SURVEY PARTY
 APPROVED AND SIGNED BY _____ DATE _____
MICHIGAN REGISTERED LAND SURVEYOR

(SEAL)

SURVEYOR'S MICHIGAN REGISTRATION NO. _____

ORANGE TOWNSHIP
KALKASKA COUNTY