

# LAND CORNER RECORDATION CERTIFICATE

## FILING REQUIREMENT OF ACT 74, MICH. P.A.1970

FOR CORNERS OF--:	LOCATED IN--:	CORNER CODE NUMBER
1. PUBLIC LAND SURVEY _____	T. <u>26</u> N. <u>●</u> R. <u>7</u> W. <u>●</u>	<u>E-9; F-9; G-9</u>
2. PROPERTY CONTROLLING IN SECTION <u>28</u>	T. <u>26</u> N. <u>●</u> R. <u>7</u> W. <u>●</u>	<u>16</u>
3. MISCELLANEOUS PROPERTY IN SECTION _____	T. _____ N. _____ R. _____ E. _____ W. _____	_____
4. LOT NO. _____, RECORDED PLAT _____		
5. PRIVATE CLAIMS _____		

REGISTER OF DEEDS STAMP AND FILING NUMBER

I, Carl F. Roser, do hereby certify that under requirements of P.A. 74, Michigan P.A. of 1970, the corner points mentioned in lines 1 and 2 above were, in a field survey on October 14, 1976, established, re-established, monumented, re-monumented, recovered or restored as expressed below and in conformance with regulations and rules therefore as required in the current manual of survey instructions of the United States Department of the Interior, Bureau of Land Management or by a decree of a court of law. Furthermore, that the corner points mentioned in lines 3, 4 and 5 above were, in a field survey on \_\_\_\_\_, 19\_\_\_\_, found, recovered, restored, established or re-established as expressed below and in conformance with the rules of the Michigan State Board of Registration for Land Surveyors or, by a Decree of a Court of law:

~~A. Description of original monument and accessories and/or subsequent restoration~~

C. (continued)

16
Drove 5/8"x36" rerod w/plastic cap & cedar post w/loc. tag
26" Oak      N02°W      29.47
8" Maple      N83°E      59.80
9" Maple      N35°W      40.85
Fd. 1/2" rerod      S45°E      2.80

B. Description of corner evidence found and/or method applied in restoring or re-establishing corner:

- E-9 Found & accepted 1 1/2" pipe as fd. & used by RLS #16939 in cert. survey. Same point as recovered by MSHD in 1946 and 1958.
- F-9 Fd. & accepted 1/2" rerod by RLS #16939 at old corner fence post, fence remains N-S-E-W.
- G-9 Reestablished NE corner of Sec. 29 on avg. line of old fence remains to W (on high ground) & opposite (8'±N) of the end of this same fence remains from W (in slight curve in swp.). Restoration by this method fits U.S. (resurvey by Wm. Burt 1849). Swp. edge ties as follows: N - 110' mea. (±10); US = 99' to nearest 1/2 chain. E - 335' mea.; US = 338' to nearest chain. W - 150'± mea.; US = 198' to nearest chain. S - 577' mea.; US=561'to nearest 1/2 chain.
- 16 Established 1/16 corner equidistant & on line between fd. SE & S 1/4 corner of Sec. 28.


C. Description of monument for corner and accessories established to perpetuate locating the position of the corner:

	E-9	F-9	G-9
Fd. 1 1/2" pipe & drove cedar post w/loc. tag (in lake)		Fd. 1/2" rerod & added DNR mon. & cedar post	Set DNR mon. on 1 1/4"x72" pipe & cedar post
14" W. Pine      N10°E      67.25		32" Oak      S21°W      34.43	9" W. Pine      N81°W      35.20
24" W. Pine      N15°W      83.00		8" Maple      N74°W      28.26	10" Tamarack      S12°E      53.53
22" W. Pine      N67°W      88.10		8" R. Pine      N58°E      44.99	8" W. Pine      S82°E      72.09
Lake Shore      Due N      20'±			9" Tamarack      N41°E      64.55

SIGNED BY Carl F. Roser

DATE 10-31-77

SURVEYOR'S MICHIGAN REGISTRATION NO. 12028

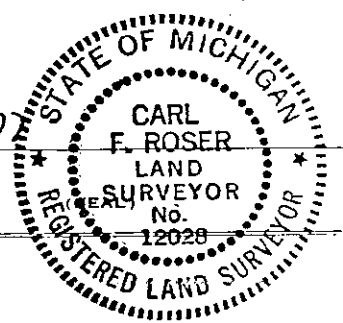

FOR STATE AND UNITED STATES AGENCIES:

SIGNED BY \_\_\_\_\_ DATE \_\_\_\_\_

APPROVED AND SIGNED BY \_\_\_\_\_ DATE \_\_\_\_\_

SURVEYOR'S MICHIGAN REGISTRATION NO. \_\_\_\_\_

ORANGE TOWNSHIP  
KALKASKA COUNTY