

**LAND CORNER RECORDATION CERTIFICATE**  
**Filing Requirement of Act 74, Mich. P.A. 1970**

For corners in

<u>KALKASKA</u>	Located In:	Corner Code #
(County)		
1998 REMONUMENTATION		
1. Public Land Survey	<u>T 26N R 8W</u>	<u>C-6</u>
	T <u>    </u> R <u>    </u>	<u>    </u>
	T <u>    </u> R <u>    </u>	<u>    </u>
	T <u>    </u> R <u>    </u>	<u>    </u>
2. Property Controlling	S <u>    </u> T <u>    </u> R <u>    </u>	<u>    </u>
in Section	S <u>    </u> T <u>    </u> R <u>    </u>	<u>    </u>
3. Miscellaneous	S <u>    </u> T <u>    </u> R <u>    </u>	<u>    </u>
Property in Sec.	S <u>    </u> T <u>    </u> R <u>    </u>	<u>    </u>

**SURVEY &  
REMONUMENTATION**

**FEB 22 1999**

**SECTION**

Register of Deeds Stamp & File Number

4. Lot No. \_\_\_\_\_, Recorded Plat \_\_\_\_\_

5. Private Claims \_\_\_\_\_

	A	B	C	D	E	F	G	H	I	J	K	L
1												
2		6		5		4		3		2		1
3												
4		7		8		9		10		11		12
5												
6		18		17		16		15		14		13
7												
8		19		20		21		22		23		24
9												
10		30		29		28		27		26		25
11												
12		31		32		33		34		35		36
13												

I, EUGENE FARRIER, in a field survey on November 3, 1998 do hereby state that under requirements of P.A. 74, Michigan P.A. of 1970, the corner points mentioned in lines 1 and 2 above were in conformance with regulations and rules therefore as required in the current manual of survey instructions of the United States Department of the Interior, Bureau of Land Management or by a decree of a Court of Law and /or that the corner points mentioned in lines 3, 4 and 5 above were in conformance with the rules of the Michigan Board of Land Surveyors or by a Decree of a Court of Law; established, re-established, monumented, recovered, found as expressed below:

**NOTE: Not more than 2 corners, all in the same town and range, may be recorded on this certificate.**

**A. Description of original monument and accessories and/or subsequent restoration:**

C-6: 1/4 Cor. Common to Secs. 17 & 18, T26N-R8W, Boardman Township  
1852, GLO. Sub. resurvey by V.W. Cankin D.S.; set corner; Y. Pine 16", N9°E, 1.71 Lks. (112.86'); Y. Pine 16" S11.5°W, 1.29 Lks. (85.14')  
5-16-1918, Road Survey by W.S. Merrill, Co. Survey Bk, Pg. 51, did not find corner.  
1967, DNR set mon., 21.16' South of the intended M.P.O.L. position  
7-3-86, N.B. DeYoung, set iron & cap #20705 M.P.O.L., Certificate of Survey, rec. in Liber 3, Pg. 36  
12-13-88, E. Farrier, fd. iron & cap #20705 Certificate of Survey  
7-23-90, E. Farrier, moved DNR to N.B. DeYoungs M.P.O.L. position as recorded in LCRC Liber 2, Pg. 419.

**B. Description of corner evidence found and/or method applied in restoring or reestablishing corner:**


C-6: 1/4 Cor. Common to Secs. 17 & 18, T26N-R8W, Boardman Township  
Found and accepted DNR mon. 2' West of CL road (as recorded in Liber 2, Pg. 419) left in place  
N35°W, 7.75' - 6" W. Pine, found nail  
N40°E, 18.25' - 6" J. Pine, found nail  
S50°E, 22.10' - 14" W. Pine, found nail  
S50°W, 59.70' - 12" W. Pine, found nail  
No G.L.O. witnesses were found.  
Kalkaska County Peer Group accepted the above monument as a careful and faithful reestablishment of the position of the original corner:

**Ratified by Peer Group**  
**P.A. 345 - 1990 Kalkaska County**

Chairman Eugene Farrier  
Date 2-2-99

**C. Description of monument for corner and accessories established to perpetuate locating the position of the corner:**

C-6: 1/4 Cor. Common to Secs. 17 & 18, T26N-R8W, Boardman Township  
Fd. & accepted DNR mon. 2' West of CL rd., left in place  
N35°W, 7.75' - 6" W. Pine, found nail  
N40°E, 18.25' - 6" J. Pine, found nail  
S50°E, 22.10' - 14" W. Pine, found nail  
S50°W, 59.70' - 12" W. Pine, found nail

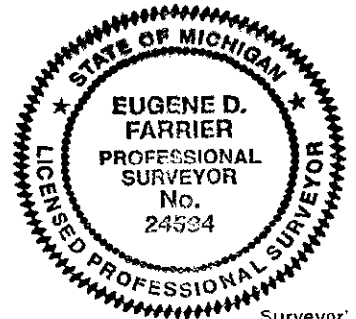

Signed by Eugene Farrier  
Michigan License No. 24594

Date 2-8-99 Surveyor



**3012689**  
Page: 1 of 1  
02/10/1999 08:43A  
LB: 5 PG: 344