

LAND CORNER RECORDATION CERTIFICATE
Filing Requirement of Act 74, Mich. P.A. 1970

For corners in

<u>KALKASKA</u>	Located In:	Corner Code #
(County)		
1998 REMONUMENTATION		
1. Public Land Survey	T. <u>26N</u> R. <u>8W</u>	<u>C-7</u>
	T. _____ R. _____	_____
	T. _____ R. _____	_____
	T. _____ R. _____	_____
2. Property Controlling in Section	S. _____ T. _____ R. _____	_____
	S. _____ T. _____ R. _____	_____
3. Miscellaneous Property in Sec.	S. _____ T. _____ R. _____	_____
	S. _____ T. _____ R. _____	_____

**SURVEY &
REMONUMENTATION**

FEB 22 1999

SECTION


Register of Deeds Stamp & File Number

4. Lot No. _____, Recorded Plat _____

5. Private Claims _____

I, EUGENE FARRIER, in a field survey on October 29, 1998 do hereby state that under requirements of P.A. 74, Michigan P.A. of 1970, the corner points mentioned in lines 1 and 2 above were in conformance with regulations and rules therefore as required in the current manual of survey instructions of the United States Department of the Interior, Bureau of Land Management or by a decree of a Court of Law and /or that the corner points mentioned in lines 3, 4 and 5 above were in conformance with the rules of the Michigan Board of Land Surveyors or by a Decree of a Court of Law; established, re-established, monumented, recovered, found as expressed below:

NOTE: Not more than 2 corners, all in the same town and range, may be recorded on this certificate.

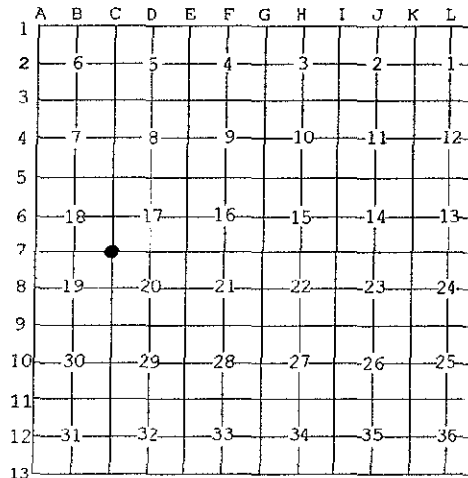

A. Description of original monument and accessories and/or subsequent restoration:
C-7: Sec. Cor. Common to Secs. 17, 18, 19, & 20, T26N-R8W, Boardman Township
1852, G.L.O. Sub. Resurvey of Twp., by V.W. Cankin DS., set post; Hemlock 12", N48°W, 6 Lk. (3.96'); Hemlock 14", S76°E, 39 Lk. (25.74')
1879, Road Survey by D.E. McVean CS., Co. Survey Bk. Pg. 35; fd. corner
1906, Sec. Sub. Survey by W.S. Merrill CS., FB # 22, pg. 78; found stone for corner.
1918, Road Survey by W.S. Merrill CS., Co. Survey Bk. Pg. 51; fd. Cedar stake and stump.
9-1967, Ken Ostling, DNR Survey, set 1/2" X 12" rod proportionate measurement between 1/4 line fences & county surveyor's record distance from the South. Ostling had record of a stone at corner, but couldn't recover it.
11-9-78, J. Fletcher fd. 1/2" iron w/ acc. LCRC rec. in Liber 2, Pg. 135
7-3-86, N.B. DeYoung fd. 1/2" iron w/acc., rec. in Lib. 3, Pg. 36
5-17-90, E. Farrier fd. 1/2" iron w/acc.

B. Description of corner evidence found and/or method applied in restoring or reestablishing corner:
C-7: Sec. Cor. Common to Secs. 17, 18, 19, & 20, T26N-R8W, Boardman Township
Fd. & accepted 1/2" iron in CL Supply Road & 6' West of CL road to North & 2-Track to South. Pulled & set 5/8" X 18" re-rod in mon. box
No G.L.O. witnesses were found.
Kalkaska County Peer Group accepted the above monument as a careful and faithful reestablishment of the position of the original corner.

Ratified by Peer Group
P.A. 345 - 1990 Kalkaska County
Chairman Eugene Farrier
Date 2-2-99

C. Description of monument for corner and accessories established to perpetuate locating the position of the corner:
C-7: Sec. Cor. Common to Secs. 17, 18, 19, & 20, T26N-R8W, Boardman Township
Fd. & accepted 1/2" iron in CL Supply Road & 6' West of CL road to North & 2-Track to South. Pulled & set 5/8" X 18" re-rod in mon. box
N20°W, 59.48' - 12" W. Pine, set nail & washer
N32°E, 56.88' - 4" J. Pine, set nail & washer
N70°E, 98.35' - Power pole, set nail & washer
S32°E, 72.24' - 20" R. Pine, set nail & washer

Signed by Eugene Farrier
Michigan License No. 24594

Date 2-8-99



3012690
Page: 1 of 1

02/10/1999 08:43A