

LAND CORNER RECORDATION CERTIFICATE
Filing Requirement of Act 74, Mich. P.A. 1970

For corners in

<u>KALKASKA</u>	Located In:	Corner Code #
(County)		
1998 REMONUMENTATION		
1. Public Land Survey	T <u>26N</u> R <u>8W</u>	<u>C-8</u>
	T _____ R _____	_____
	T _____ R _____	_____
	T _____ R _____	_____
2. Property Controlling	S _____ T _____ R _____	_____
in Section	S _____ T _____ R _____	_____
3. Miscellaneous	S _____ T _____ R _____	_____
Property in Sec.	S _____ T _____ R _____	_____

**SURVEY &
REMONUMENTATION**

FEB 22 1999

SECTION

Register of Deeds Stamp & File Number

4. Lot No. _____, Recorded Plat _____

5. Private Claims _____

I, EUGENE FARRIER, in a field survey on November 3, 1998, do hereby state that under requirements of P.A. 74, Michigan P.A. of 1970, the corner points mentioned in lines 1 and 2 above were in conformance with regulations and rules therefore as required in the current manual of survey instructions of the United States Department of the Interior, Bureau of Land Management or by a decree of a Court of Law and /or that the corner points mentioned in lines 3, 4 and 5 above were in conformance with the rules of the Michigan Board of Land Surveyors or by a Decree of a Court of Law; established, re-established, monumented, recovered, found as expressed below:

A	B	C	D	E	F	G	H	I	J	K	L	M
1												
2	6	5	4	3	2	1						
3												
4	7	8	9	10	11	12						
5												
6	18	17	16	15	14	13						
7												
8	19	20	21	22	23	24						
9												
10	30	29	28	27	26	25						
11												
12	31	32	33	34	35	36						
13												

NOTE: Not more than 2 corners, all in the same town and range, may be recorded on this certificate.

A. Description of original monument and accessories and/or subsequent restoration:

C-8: 1/4 Cor. Common to Secs. 19 & 20, T26N-R8W, Boardman Township
 1852, GLO. Sub. resurvey by V.W. Cankin D.S.; set corners; Sugar 12", S80°W, 16 Lks. (10.56'); Beech 8", N56°E, 29 Lks. (19.14')
 1906, Sec. Sub. Survey by W.S. Merrill CS., FB # 22, Pg. 78; found stone
 8-9-94, E. Farrier, set 1/2" iron & cap #24594 by splitting old r.o.w. fences & on old remains of fence to East, Cert. of Survey

B. Description of corner evidence found and/or method applied in restoring or reestablishing corner:

C-8: 1/4 Cor. Common to Secs. 19 & 20, T26N-R8W, Boardman Township
 Fd. & accepted 1/2" iron & cap #24594 (set by occupation), 3' East of CL rd and on old fence remains to East (as shown in previous Cert. of Surveys) Pulled & set 5/8" X 18" re-rod w/brass cap.
 N50°E, 21.13' - 12" Maple, found nail
 S30°E, 24.18' - 6" Maple, found nail
 S60°W, 29.51' - 12" Maple, found nail
 N50°W, 24.21' - 10" Maple, found nail
 No G.L.O. witnesses were found.

Kalkaska County Peer Group accepted the above monument as the best available evidence of the position of the original corner.


Ratified by Peer Group
P.A. 345 - 1990 Kalkaska County
 Chairman Eugene Farrier
 Date 2-2-99

C. Description of monument for corner and accessories established to perpetuate locating the position of the corner:

C-8: 1/4 Cor. Common to Secs. 19 & 20, T26N-R8W, Boardman Township
 Fd. & accepted 1/2" iron & cap #24594 (set by occupation), 3' East of CL rd and on old fence remains to East. Pulled & set 5/8" X 18" re-rod w/brass cap.
 N50°E, 21.13' - 12" Maple, found nail
 S30°E, 24.18' - 6" Maple, found nail
 S60°W, 29.51' - 12" Maple, found nail
 N50°W, 24.21' - 10" Maple, found nail

Signed by Eugene Farrier
 Michigan License No. 24594

Date 2-8-99

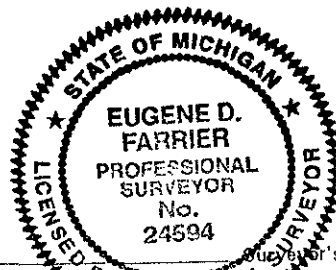

3012691
 Page: 1 of 1
 02/10/1999 08:44A
 LB: 5 PG: 346

REVISIONS:
 JAN. 28, 197
 REVISED MAY 14, 197
 REVISED JAN. 198
 REVISED OCT., 199