

LAND CORNER RECORDATION CERTIFICATE
Filing Requirement of Act 74, Mich. P.A. 1970

For corners in

KALKASKA Located In: _____ Corner Code # _____
 (County)
 1998 REMONUMENTATION
 1. Public Land Survey T 26N R 8W C-9
 T _____ R _____
 T _____ R _____
 T _____ R _____
 2. Property Controlling S _____ T _____ R _____
 in Section S _____ T _____ R _____
 3. Miscellaneous S _____ T _____ R _____
 Property in Sec. S _____ T _____ R _____

**SURVEY &
 REMONUMENTATION**

FEB 22 1999

SECTION

Register of Deeds Stamp & File Number

4. Lot No. _____, Recorded Plat _____

5. Private Claims _____

I, EUGENE FARRIER, in a field survey on November 3, 1998 do hereby state that under requirements of P.A. 74, Michigan P.A. of 1970, the corner points mentioned in lines 1 and 2 above were in conformance with regulations and rules therefore as required in the current manual of survey instructions of the United States Department of the Interior, Bureau of Land Management or by a decree of a Court of Law and for that the corner points mentioned in lines 3, 4 and 5 above were in conformance with the rules of the Michigan Board of Land Surveyors or by a Decree of a Court of Law; established, re-established, monumented, recovered, found as expressed below:

NOTE: Not more than 2 corners, all in the same town and range, may be recorded on this certificate.

1	A	B	C	D	E	F	G	H	I	J	K	L
2		6		5		4		3		2		1
3												
4		7		8		9		10		11		12
5												
6		18		17		16		15		14		13
7												
8		19		20		21		22		23		24
9												
10		30		29		28		27		26		25
11												
12		31		32		33		34		35		36
13												

A. Description of original monument and accessories and/or subsequent restoration:

C-9: Sec. Cor. Common to Secs. 19, 20, 29 & 30, T26N-R8W, Boardman Township.
 1852, GLO. Sub. resurvey by V.W. Cankin D.S.; set post at corner; Beech 8", N40°W, 29 Lks. (19.14'); Sugar 24", S24°E, 43 Lks. (28.38')
 1879, Road survey by D.E. McVean CS. Co. Survey Bk. Pg. 35; fd. corner.
 1903 & 1906, Sec. Sub. by W.S. Merrill CS., Co. Survey Bk., Pg. 34, Also Pg. 33, & FB # 22, Pg. 78, notes iron stake at corner.
 1905, Sec. Sub. by W.S. Merrill CS., Co. Survey Bk. Pg. 39; fd. corner; Elm 8", N39°W, 60 1/2 Lks. (39.90'); Maple 6", S60°W, 43 Lks. (28.71')
 9-17-82, N. DeYoung, fd. 1 1/2" iron pipe, Cert. of Survey
 3-14-83, E. Farrier, fd. 1 1/2" iron pipe, Cert. of Survey

B. Description of corner evidence found and/or method applied in restoring or reestablishing corner:

C-9: Sec. Cor. Common to Secs. 19, 20, 29 & 30, T26N-R8W, Boardman Township.
 Fd & accepted 1 1/2" iron pipe 3' North of E-W rd. and in CL rd to South, 7' West of rd to North (used in previous Cert. of Surveys)
 Added 5/8" X 18" re-rod w/ brass cap.
 N28°W, 41.70' - 14" Maple, found nail
 S39°E, 69.40' - 12" Maple, found nail
 No G.L.O. witnesses were found.
 Kalkaska County Peer Group accepted the above monument as the best available evidence of the position of the original corner.

Ratified by Peer Group
 P.A. 345 - 1990 Kalkaska County

Chairman Eugene Farrier


Date 2-2-99

C. Description of monument for corner and accessories established to perpetuate locating the position of the corner:

C-9: Sec. Cor. Common to Secs. 19, 20, 29 & 30, T26N-R8W, Boardman Township.
 Fd & accepted 1 1/2" iron pipe 3' North of E-W rd. and in CL rd to South, 7' West of rd to North. Added 5/8" X 18" re-rod w/ brass cap
 N45°E, 42.90' - 22" Walnut, set nail & washer
 N28°W, 41.70' - 14" Maple, found nail
 S71°W, 46.20' - 24" Maple, set nail & washer
 S39°E, 69.40' - 12" Maple, found nail

Signed by Eugene Farrier
 Michigan License No. 24594

Date 2-8-99

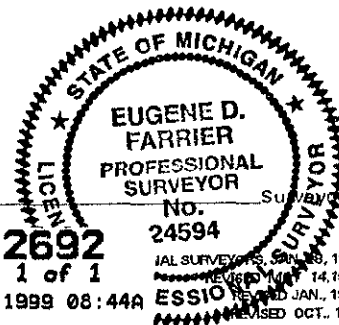

3012692
 Page: 1 of 1

No. 24594
 JAL SURVEYORS, 500 N. 18, 15
 REVISION 14, 15
 ESSIO REVISION JAN, 18
 REVISED OCT. 11