

LAND CORNER RECORDATION CERTIFICATE
Filing Requirement of Act 74, Mich. P.A. 1970

For corners in

<u>KALKASKA</u>	Located In:	Corner Code #
(County)		
1998 REMONUMENTATION		
1. Public Land Survey	T <u>26N</u> R <u>8W</u>	<u>D-9</u>
	T _____ R _____	_____
	T _____ R _____	_____
	T _____ R _____	_____
2. Property Controlling in Section	S _____ T _____ R _____	_____
	S _____ T _____ R _____	_____
3. Miscellaneous Property in Sec.	S _____ T _____ R _____	_____
	S _____ T _____ R _____	_____

SURVEY & REMONUMENTATION

FEB 22 1999

SECTION


Register of Deeds Stamp & File Number

4. Lot No. _____, Recorded Plat _____

5. Private Claims _____

I, EUGENE FARRIER, in a field survey on November 3, 1998, do hereby state that under requirements of P.A. 74, Michigan P.A. of 1970, the corner points mentioned in lines 1 and 2 above were in conformance with regulations and rules therefore as required in the current manual of survey instructions of the United States Department of the Interior, Bureau of Land Management or by a decree of a Court of Law and /or that the corner points mentioned in lines 3, 4 and 5 above were in conformance with the rules of the Michigan Board of Land Surveyors or by a Decree of a Court of Law; established, re-established, monumented, recovered, found as expressed below:

NOTE: Not more than 2 corners, all in the same town and range, may be recorded on this certificate.

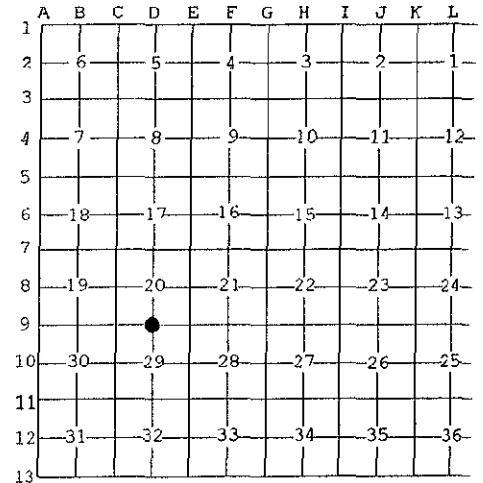

A. Description of original monument and accessories and/or subsequent restoration:

D-9: 1/4 Cor. Common to Secs. 20 & 29, T26N-R8W, Boardman Township
 1852, GLO sub. resurvey by V.W. Cankin D.S.; set corner; Tamarack 8", N17°W, 31 Lks (20.46'); Tamarack 5", S38°W, 35 Lks (23.10)', East edge swamp CL NW-SE, East 8.58 Chs. (566.3'); W. edge swamp C. N-SW, 2.92 Chs. (192.7')
 1879, Road survey by D.E. McVean, CS., Co. Survey Bk., Pg. 35, fd. corner
 1905, Sec. sub. survey by W.S. Merrill CS. Co. Survey Bk., Pg. 39; iron stake at corner
 3-14-83, E. Farrier, set 1/2" iron & cap #24594 by using M.D.S.H. witnesses from 1938, 5" Tamarack N44°E, 41.42'; 5" Tamarack, S18°E, 41.88'; 3" Tamarack, S50°W, 38.63', Cert. of Survey
 11-26-85, E. Farrier, fd 1/2" iron & cap #24594, Cert. of Survey
 12-13-85, E. Farrier, fd 1/2" iron & cap #24594, Cert. of Survey
 8-9-89, J. Wilcox, fd. 1/2" iron, Lib. 3, Pg. 413, Cert. of Survey
 8-9-94, E. Farrier, fd 1/2" iron, Cert. of Survey


Ratified by Peer Group
P.A. 345 - 1990 Kalkaska County
 Chairman Eugene Farrier
 Date 2-2-99

B. Description of corner evidence found and/or method applied in restoring or reestablishing corner:

D-9: 1/4 Cor. Common to Secs. 20 & 29, T26N-R8W, Boardman Township
 Fd. & accepted 1/2" iron in CL E-W rd and 4' East of CL Quarterline Rd & in CL of o.r.v. trail to South (as shown in prev. Cert. of Survey); Pulled & set 5/8" X 18" re-rod and brass cap
 N35°W, 34.1' - Found stop sign post
 N50°E, 45.77' - Power pole, found nail
 S55°E, 75.55' - Guy pole, found nail
 No G.L.O. witnesses were found.
 Kalkaska County Peer Group accepted the above monument as the best available evidence of the position of the original corner.

C. Description of monument for corner and accessories established to perpetuate locating the position of the corner:

D-9: 1/4 Cor. Common to Secs. 20 & 29, T26N-R8W, Boardman Township
 Fd. & accepted 1/2" iron in CL E-W rd and 4' East of CL Quarterline Rd & in CL of o.r.v. trail to South. Pulled & set 5/8" X 18" re-rod and brass cap
 N35°W, 34.1' - Found stop sign post
 N50°E, 45.77' - Power pole, found nail
 S55°E, 75.55' - Guy pole, found nail
 S05°W, 59.10' - 6" J. Pine, set nail & washer

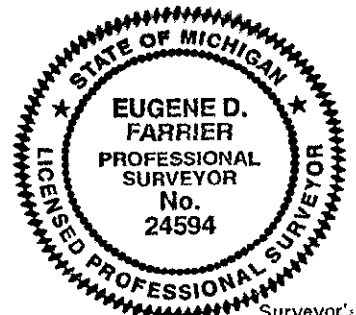

Signed by Eugene Farrier
 Michigan License No. 24594

Date 2-8-99 Surveyor's