

**LAND CORNER RECORDATION CERTIFICATE**  
**Filing Requirement of Act 74, Mich. P.A. 1970**

For corners in

KALKASKA Located In: \_\_\_\_\_ Corner Code # \_\_\_\_\_  
(County)  
**1998 REMONUMENTATION**  
**1. Public Land Survey** T 26N R 8W D-11  
 T \_\_\_\_\_ R \_\_\_\_\_  
 T \_\_\_\_\_ R \_\_\_\_\_  
 T \_\_\_\_\_ R \_\_\_\_\_  
**2. Property Controlling** S \_\_\_\_\_ T \_\_\_\_\_ R \_\_\_\_\_  
 in Section S \_\_\_\_\_ T \_\_\_\_\_ R \_\_\_\_\_  
**3. Miscellaneous** S \_\_\_\_\_ T \_\_\_\_\_ R \_\_\_\_\_  
 Property in Sec. S \_\_\_\_\_ T \_\_\_\_\_ R \_\_\_\_\_

**SURVEY &  
 REMONUMENTATION**

**FEB 22 1999**

**SECTION**

Register of Deeds Stamp & File Number

4. Lot No. \_\_\_\_\_, Recorded Plat \_\_\_\_\_

5. Private Claims \_\_\_\_\_

I, EUGENE FARRIER, in a field survey on November 2, 1998 do hereby state that under requirements of P.A. 74, Michigan P.A. of 1970, the corner points mentioned in lines 1 and 2 above were in conformance with regulations and rules therefore as required in the current manual of survey instructions of the United States Department of the Interior, Bureau of Land Management or by a decree of a Court of Law and /or that the corner points mentioned in lines 3, 4 and 5 above were in conformance with the rules of the Michigan Board of Land Surveyors or by a Decree of a Court of Law; established, re-established, monumented, recovered, found as expressed below:

1	A	B	C	D	E	F	G	H	I	J	K	L	M
2		6		5		4		3		2		1	
3													
4		7		8		9		10		11		12	
5													
6		10		17		16		15		14		13	
7													
8		19		20		21		22		23		24	
9													
10		30		29		28		27		26		25	
11													
12		31		32		33		34		35		36	
13													

**NOTE:** Not more than 2 corners, all in the same town and range, may be recorded on this certificate.

A. Description of original monument and accessories and/or subsequent restoration:

D-11: 1/4 Cor. Common to Secs. 20 & 29, T26N-R8W, Boardman Township  
 1852, GLO Sub. Resurvey of Twp., by V.W. Cankin D.S.; set corner; Beech 12", N80°E, 14 Lks. (9.24'); Sugar 8", S15°W, 9 Lks. (5.94')  
 1879, Road Survey by D.E. McVean CS. Co. Survey Bk. Pg. 35; found corner.  
 1905, Sec. Sub. Survey by W.S. Merrill CS. Co. Survey Bk., Pg. 39.  
 12-16-74, J. Wilcox, set iron 19' West of fence to North LCRC, Liber 1, Pg. 335  
 12-16-74, J. Wilcox, shows ocr. only, liber 1, Pg. 621, Cert. of Survey  
 8-7-75, J. Wilcox, fd. 1/2" iron, Liber 1, Pg. 685


Ratified by Peer Group  
**P.A. 345 - 1990 Kalkaska County**  
 Chairman Eugene Farrier  
 Date 2-2-99

B. Description of corner evidence found and/or method applied in restoring or reestablishing corner:

D-11: 1/4 Cor. Common to Secs. 20 & 29, T26N-R8W, Boardman Township  
 Found and accepted 5/8" re-rod in centerline road which fits witnesses from LCRC, Liber 1, Pg. 335, corner falls 4' East of trail road to North  
 Added brass cap  
 S70°E, 85.94'- 24" Twin Maple, fd nail  
 No G.L.O. witnesses were found.  
 Kalkaska County Peer Group accepted the above monument as a careful and faithful reestablishment of the position of the original corner:

C. Description of monument for corner and accessories established to perpetuate locating the position of the corner:

D-11: 1/4 Cor. Common to Secs. 20 & 29, T26N-R8W, Boardman Township  
 Found and accepted 5/8" re-rod in centerline road which fits witnesses from LCRC, Liber 1, Pg. 335, corner falls 4' East of trail road to North. Added brass cap  
 S70°E, 85.94'- 24" Twin Maple, fd nail  
 S18°E, 24.57', 6" R. Pine, fd nail  
 S60°W, 44.47'- 18" Oak, fd nail  
 N35°W, 40.29'- power pole, set nail

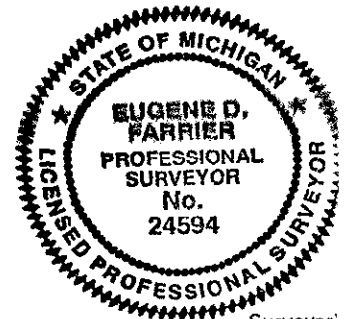

Signed by Eugene Farrier  
 Michigan License No. 24594

Date 2-8-99 Surveyor'