

LAND CORNER RECORDATION CERTIFICATE
Filing Requirement of Act 74, Mich. P.A. 1970

For corners in

<u>KALKASKA</u>	Located In:	Corner Code #
(County)		
1998 REMONUMENTATION		
1. Public Land Survey	T <u>26N</u> R <u>8W</u>	<u>E-5</u>
	T _____ R _____	_____
	T _____ R _____	_____
	T _____ R _____	_____
2. Property Controlling in Section	S _____ T _____ R _____	_____
	S _____ T _____ R _____	_____
3. Miscellaneous Property in Sec.	S _____ T _____ R _____	_____
	S _____ T _____ R _____	_____

**SURVEY &
 REMONUMENTATION**

FEB 22 1999

SECTION


Register of Deeds Stamp & File Number

4. Lot No. _____, Recorded Plat _____

5. Private Claims _____

I, EUGENE FARRIER, in a field survey on November 3, 1998 do hereby state that under requirements of P.A. 74, Michigan P.A. of 1970, the corner points mentioned in lines 1 and 2 above were in conformance with regulations and rules therefore as required in the current manual of survey instructions of the United States Department of the Interior, Bureau of Land Management or by a decree of a Court of Law and for that the corner points mentioned in lines 3, 4 and 5 above were in conformance with the rules of the Michigan Board of Land Surveyors or by a Decree of a Court of Law; established, re-established, monumented, recovered, found as expressed below:

NOTE: Not more than 2 corners, all in the same town and range, may be recorded on this certificate.

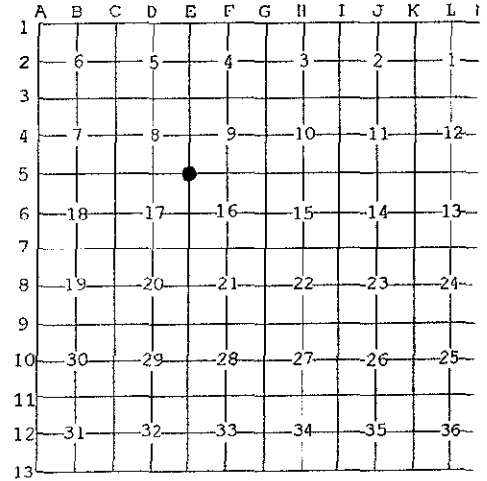

A. Description of original monument and accessories and/or subsequent restoration:

E-5: Sec. Cor. Common to Secs. 8, 9, 16, & 17, T26N-R8W, Boardman Township
 1852, GLO. Sub. resurvey by V.W. Cankin D.S.; set post at corner; W. Pine 18", N3°W, 37 Lks. (24.42'); Y. Pine 18", S45°E, 1.08 Lks (71.28')
 1880, Road Survey by Leo Gimpert S. Co. Survey Bk. Pg. 35; found corner
 1895, Road Survey by E.B. Dennis CS. Co. Survey Bk., Pg. 57; found corner
 1902, 1908, Sec. & Parcel Sub. Survey by W.S. Merrill CS., FB # 4, Pg. 67, & FB # 23, Pg. 44; shows corner only
 1907, Sec. Sub. Survey by W.S. Merrill CS., FB # 22, Pg. 141; shows stone corner.
 1967, Ken Ostling, DNR, fd. old stake bottom at fence corner which fit record distances to GLO calls. Added DNR mon.
 1978, C.F. Roser, fd. DNR mon. and upgraded witnesses
 5-17-1978, C. F. Roser upgraded previous Dept. cor of record (1967) LCRC, Lib.2, Pg. 124
 7-3-1986, N.B. DeYoung fd. DNR mon. w/acc., rec. in Lib. 3, Pg. 36
 3-30-94, E. Farrier fd. DNR mon. w/acc., Cert. of Survey
 7-10-98, E. Farrier fd. DNR mon. w/acc., Cert. of Survey

Ratified by Peer Group
P.A. 345 - 1990 Kalkaska County
 Chairman Eugene Farrier
 Date 2-2-99

B. Description of corner evidence found and/or method applied in restoring or reestablishing corner:

E-5: Sec. Cor. Common to Secs. 8, 9, 16, & 17, T26N-R8W, Boardman Township
 Fd. & accepted DNR mon. 47' East of CL N-S rd and in CL E-W 2-Track (as recorded in LCRC, Liber 2, Pg. 124) left in place
 Fd. nail, 8" Tri-Maple, N18°E, 35.40'
 Fd. nail 12" Poplar, S48°W, 26.65'
 No G.L.O. witnesses were found.
 Kalkaska County Peer Group accepted the above monument as a careful and faithful perpetuation of the position of the original corner.

C. Description of monument for corner and accessories established to perpetuate locating the position of the corner:

E-5: Sec. Cor. Common to Secs. 8, 9, 16, & 17, T26N-R8W, Boardman Township
 Fd. & accepted DNR mon. 47' East of CL N-S rd and in CL E-W 2-Track, left in place
 N50°W, 20.18' - 8" J. Pine, set nail & washer
 N05°W, 24.54' - 6" W. Pine, set nail & washer
 N18°E, 35.40' - 8" Tri-Maple, found nail
 S48°W, 26.65' - 12" Poplar, found nail



Signed by Eugene Farrier
 Michigan License No. 24594

Date 2-8-99 Surveyor's

3012702
 Page: 1 of 1
 02/10/1999 08:49
 LB: 5 PG: 357

Kalkaska County REMON 9.00