

LAND CORNER RECORDATION CERTIFICATE
Filing Requirement of Act 74, Mich. P.A. 1970

For corners in

KALKASKA Located In: Corner Code #
 (County)
 1998 REMONUMENTATION
 1. Public Land Survey T. 26N R. 8W E-6
 T. R.
 T. R.
 T. R.
 2. Property Controlling S. T. R.
 in Section S. T. R.
 3. Miscellaneous S. T. R.
 Property in Sec. S. T. R.

**SURVEY &
 REMONUMENTATION**

FEB 22 1999

SECTION

Register of Deeds Stamp & File Number

4. Lot No. _____, Recorded Plat _____
 5. Private Claims _____

	A	B	C	D	E	F	G	H	I	J	K	L	N
1													
2		6		5		4		3		2		1	
3													
4		7		8		9		10		11		12	
5													
6		18		17	●	16		15		14		13	
7													
8		19		20		21		22		23		24	
9													
10		30		29		28		27		26		25	
11													
12		31		32		33		34		35		36	
13													

I, EUGENE FARRIER, in a field survey on November 3, 1998 do hereby state that under requirements of P.A. 74, Michigan P.A. of 1970, the corner points mentioned in lines 1 and 2 above were in conformance with regulations and rules therefore as required in the current manual of survey instructions of the United States Department of the Interior, Bureau of Land Management or by a decree of a Court of Law and /or that the corner points mentioned in lines 3, 4 and 5 above were in conformance with the rules of the Michigan Board of Land Surveyors or by a Decree of a Court of Law; established, re-established, monumented, recovered, found as expressed below:

NOTE: Not more than 2 corners, all in the same town and range, may be recorded on this certificate.

A. Description of original monument and accessories and/or subsequent restoration:

E-6: 1/4 Cor. Common to Secs. 16 & 17, T26N-R8W, Boardman Township
 1852, GLO. Sub. resurvey by V.W. Cankin D.S.; set corner; W. Pine 24", N67°W, 70 Lks. (46.20'); W. Pine 30", N78°W, 1.15 Lks. (75.90'); stream 40 Lks. C.W., North, 4 Chs. (264.0')
 1880, Road Survey by Leo Gimpert S. Co. Survey Bk., Pg. 35, found corner.
 1902, Sec. Sub. Survey by W.S. Merrill CS. FB # 4, Pg. 67, shows corner only.
 1907, Sec. Sub. Survey by W.S. Merrill CS. FB # 22, Pg. 141; established corner by proportional dist.
 1967, K. Ostling (DNR) found 1/2" bar, 33' East of corner of fence around cemetery
 9-18-78, C.F. Roser, fd. 1/2" rod buried raised w/ 3/4" X 18" iron pipe, LCRC rec. in Lib. 2, Pg. 125 which is corner of record (1967)
 7-3-86, N.B. DeYoung, fd. 3/4" pipe w/acc. & accepted, rec. in Lib. 3, Pg. 36
 12-13-88, E. Farrier, fd. 3/4" pipe w/acc. & accepted, Cert. of Survey


B. Description of corner evidence found and/or method applied in restoring or reestablishing corner:

E-6: 1/4 Cor. Common to Secs. 16 & 17, T26N-R8W, Boardman Township
 Fd. & accepted 3/4" iron pipe in CL road on fence to West (as recorded in LCRC, Liber 2, Pg. 125 and previous Cert. of Surveys) Added 5/8" X 18" re-rod w/brass cap.
 N16°E, 84.04' - 22" W. Pine, found nail
 East 22.15' - Power pole, found nail
 West 32.79' - 6" X 6" wood post
 No G.L.O. witnesses were found.
 Kalkaska County Peer Group accepted the above monument as a careful and faithful reestablishment of the position of the original corner.

Ratified by Peer Group
 P.A. 345 - 1990 Kalkaska County
 Chairman Eugene Farrier
 Date 2-2-99

C. Description of monument for corner and accessories established to perpetuate locating the position of the corner:

E-6: 1/4 Cor. Common to Secs. 16 & 17, T26N-R8W, Boardman Township
 Fd. & accepted 3/4" iron pipe in CL road on fence to West. Added 5/8" X 18" re-rod w/brass cap.
 N16°E, 84.04' - 22" W. Pine, found nail
 East 22.15' - Power pole, found nail
 West 32.79' - 6" X 6" wood post
 S30°W, 47.73' - 6" R. Pine, set nail & washer

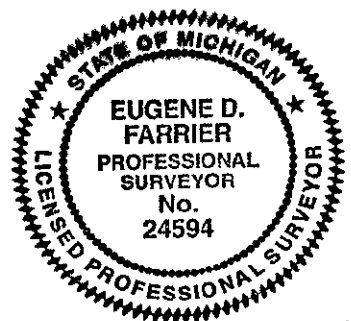

Signed by Eugene Farrier
 Michigan License No. 24594

Date 2-8-99 Surveyor's