

LAND CORNER RECORDATION CERTIFICATE
Filing Requirement of Act 74, Mich. P.A. 1970

For corners in

<u>KALKASKA</u> (County)	Located in:	Corner Code #
1998 REMONUMENTATION	T <u>26N</u> R <u>8W</u>	<u>E-11</u>
1. Public Land Survey	T _____ R _____	_____
	T _____ R _____	_____
	T _____ R _____	_____
2. Property Controlling in Section	S _____ T _____ R _____	_____
	S _____ T _____ R _____	_____
3. Miscellaneous Property in Sec.	S _____ T _____ R _____	_____
	S _____ T _____ R _____	_____

**SURVEY &
REMONUMENTATION**

FEB 22 1999

SECTION

Register of Deeds Stamp & File Number

4. Lot No. _____, Recorded Plat _____

5. Private Claims _____

I, EUGENE FARRIER, in a field survey on October 30, 1998 do hereby state that under requirements of P.A. 74, Michigan P.A. of 1970, the corner points mentioned in lines 1 and 2 above were in conformance with regulations and rules therefore as required in the current manual of survey instructions of the United States Department of the Interior, Bureau of Land Management or by a decree of a Court of Law and for that the corner points mentioned in lines 3, 4 and 5 above were in conformance with the rules of the Michigan Board of Land Surveyors or by a Decree of a Court of Law; established, re-established, monumented, recovered, found as expressed below:

NOTE: Not more than 2 corners, all in the same town and range, may be recorded on this certificate.

1	A	B	C	D	E	F	G	H	I	J	K	L
2		6		5		4		3		2		1
3												
4		7		8		9		10		11		12
5												
6		18		17		16		15		14		13
7												
8		19		20		21		22		23		24
9												
10		30		29		28		27		26		25
11												
12		31		32		33		34		35		36
13												

A. Description of original monument and accessories and/or subsequent restoration:

E-11: Sec. Cor. Common to Secs. 28, 29, 32, & 33, T26N-R8W, Boardman Township
 1852, GLO. Sub. Resurvey of Twp., by V.W. Cankin D.S.; set post for corner; Sugar 12", N66°W, 28 Lks. (18.48'); Sugar 10", S418E, 14 Lks. (9.24')
 1879, 1882, Road Survey by D.E. McVean CS. & E. Mosher CS., Co. Survey, Bk. Pg. 35 & 36; found corner.
 1898, 1900, 1901, Sec. Sub. Survey by W.S. Merrill CS., Co. Survey Bk. Pg. 39 & 50; stone at corner; Elm 7" N36°E, 77 Lks. (50.82')
 1905 & 1915, Sec. sub survey by W.S. Merrill CS, Co. Survey Bk. Pg. 39 & 50; stone at corner; Elm 7', N36°E, 77 Lks. (50.82')
 12-16-74, J. Wilcox, set 1/2" iron from old witnesses LCRC, Liber 1, Pg. 335
 7-17-78, J. Fletcher, fd. 1/2" iron & cap #14102, Liber 2, Pg. 214, Cert. of Survey
 3-14-83, E. Farrier, fd. 1/2" iron, Cert. of Survey
 6-5-98, E. Farrier, fd. 1/2" iron, Cert. of Survey

Ratified by Peer Group
P.A. 345 - 1990 Kalkaska County
 Chairman Eugene Farrier
 Date 2-2-99


B. Description of corner evidence found and/or method applied in restoring or reestablishing corner:

E-11: Sec. Cor. Common to Secs. 28, 29, 32, & 33, T26N-R8W, Boardman Township
 Fd. & accepted 1/2" X 24" iron in centerline Woodman Road and 4' West of centerline Hudson Road
 Pulled & set 5/8" X 18" re-rod w/brass cap
 N22°W, 76.41'- 24" Maple, fd. nail
 N30°E, 75.17'- 24" Ash, fd. nail
 S36°W, 67.82'- 12" R. Pine, fd. nail
 No G.L.O. witnesses were found.

Kalkaska County Peer Group accepted the above monument as a careful and faithful reestablishment of the position of the original corner.

C. Description of monument for corner and accessories established to perpetuate locating the position of the corner:

E-11: Sec. Cor. Common to Secs. 28, 29, 32, & 33, T26N-R8W, Boardman Township
 Fd. & accepted 1/2" X 24" iron in centerline Woodman Road and 4' West of centerline Hudson Road
 Pulled & set 5/8" X 18" re-rod w/brass cap
 N22°W, 76.41'- 24" Maple, fd. nail
 N30°E, 75.17'- 24" Ash, fd. nail
 S45°E, 51.86'- power pole, set nail
 S36°W, 67.82'- 12" R. Pine, fd. nail
 N07°E, 17.70'- fd. 5/8" re-bar & cap #7

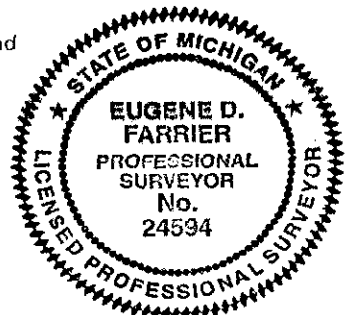

Signed by Eugene Farrier
 Michigan License No. 24594

Date 2-8-99 Surveyor



3012708
 Page: 1 of 1
 02/10/1999 08:53
 LB: 5 PG: 363

Kalkaska County

REMON

9.00