

LAND CORNER RECORDATION CERTIFICATE
Filing Requirement of Act 74, Mich. P.A. 1970

For corners in

KALKASKA
 (County)

Located In:

Corner Code #

1998 REMONUMENTATION
 1. Public Land Survey

T.26N R.8W

E-13 ✓

T.25N R.8W

E-1

T. R.

T. R.

2. Property Controlling
 in Section

S. T. R.

S. T. R.

3. Miscellaneous
 Property in Sec.

S. T. R.

S. T. R.

**SURVEY &
 REMONUMENTATION**

FEB 22 1999

SECTION

Register of Deeds Stamp & File Number

4. Lot No. _____, Recorded Plat _____

5. Private Claims _____

I, EUGENE FARRIER, in a field survey on October 28, 1998 do hereby state that under requirements of P.A. 74, Michigan P.A. of 1970, the corner points mentioned in lines 1 and 2 above were in conformance with regulations and rules therefore as required in the current manual of survey instructions of the United States Department of the Interior, Bureau of Land Management or by a decree of a Court of Law and /or that the corner points mentioned in lines 3, 4 and 5 above were in conformance with the rules of the Michigan Board of Land Surveyors or by a Decree of a Court of Law; established, re-established, monumented, recovered, found as expressed below:

A	B	C	D	E	F	G	H	I	J	K	L
1											
2	6		5		4		3		2		1
3											
4	7		8		9		10		11		12
5											
6	18		17		16		15		14		13
7											
8	19		20		21		22		23		24
9											
10	30		29		28		27		26		25
11											
12	31		32		33		34		35		36
13											

NOTE: Not more than 2 corners, all in the same town and range, may be recorded on this certificate.

A. Description of original monument and accessories and/or subsequent restoration:

E-13: Sec. Cor. Common to Secs. 32 & 33, T26N-R8W, Boardman Township & E-1: Secs. 4 & 5, T25N-R8W

- 1852, GLO. Twp. Line Resurvey by V.W. Cankin, D.S.; set post for cor.; W. Pine 18", N57°W, 31 Lk. (20.46'); Hemlock 18" N3.5°E, 214 Lk. (141.24')
- 1852, GLO. Sub. of Twp. T25N-R8W, by V.W. Cankin, D.S.; found post for corner; W. Pine 18", S80°W, 40 Lk. (26.4'); Tamarack 5", S22°E, 227 Lk. (14982'); swamp c. SE-NW. W. edge, East 6.25 Chs. (412.5'); swamp C. NE-SW E. edge, West 0.5 Ch. (33.0')
- 1898, Sec. Sub. Survey by E. Mosher CS., FB # 32, Pg. 82, found corner.
- 1901, Sec. Sub. Survey by W.S. Merrill CS. Co. Survey Bk., Pg. 4 & 29, shows corner only.
- 1905, Sec. Sub. Survey by W.S. Merrill CS., Co. Survey Bk., Pg. 39; set stone at corner; one Gov't witness; added Pine stump 20", N28°W 46 Lks. (30.36')
- 6-9-81, N. DeYoung, fd. iron & cap #12581, Cert. of Survey
- 7-22-98, R. Mitchell, fd. 1" iron pipe, accepted as W.S. Merrill, but found no stone, raised w/ iron & cap #28417, Cert. of Survey, N32°E, 2.16'- 5/8" iron & cap #12581

B. Description of corner evidence found and/or method applied in restoring or reestablishing corner:

E-13: Sec. Cor. Common to Secs. 32 & 33, T26N-R8W, Boardman Township & E-1: Secs. 4 & 5, T25N-R8W


- Found and accepted iron & cap #28417 in centerline 4-way road intersection (as shown in Cert. of Survey by R. Mitchell)
- N56°W, 59.10'- 5" Hemlock, fd. nail
- S76°W, 75.54'- 8" Tri-Cherry, fd. nail
- S05°E, 102.77'- 12" Basswood, fd. nail
- N76°E, 73.00'- 5" Willow, fd. nail
- No G.L.O. witnesses were found.
- Kalkaska County Peer Group accepted the above monument as the best available evidence of the position of the original corner.

Ratified by Peer Group
 P.A. 345 - 1990 Kalkaska County
 Chairman Eugene Farrier
 Date 2-2-99

C. Description of monument for corner and accessories established to perpetuate locating the position of the corner:

E-13: Sec. Cor. Common to Secs. 32 & 33, T26N-R8W, Boardman Township & E-1: Secs. 4 & 5, T25N-R8W

- Found and accepted iron & cap #28417 in centerline 4-way road intersection (as shown in Cert. of Survey by R. Mitchell)
- Pulled and set 5/8" iron & brass cap
- N56°W, 59.10'- 5" Hemlock, fd. nail
- S76°W, 75.54'- 8" Tri-Cherry, fd. nail
- S05°E, 102.77'- 12" Basswood, fd. nail
- N76°E, 73.00'- 5" Willow, fd. nail
- N32°E, 2.16', fd. 5/8" iron & cap #12581

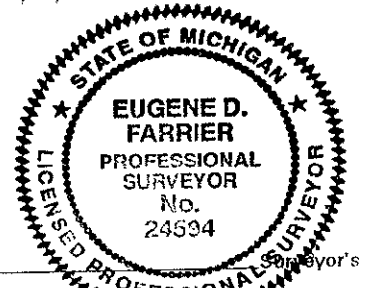

Signed by Eugene Farrier
 Michigan License No. 24594

Date 2-8-99