

LAND CORNER RECORDATION CERTIFICATE
Filing Requirement of Act 74, Mich. P.A. 1970

For corners in

KALKASKA Located In: Corner Code #
 (County)
 1998 REMONUMENTATION
 1. Public Land Survey T 26N R 8W F-5
 T R
 T R
 T R
 2. Property Controlling S T R
 in Section S T R
 3. Miscellaneous S T R
 Property in Sec. S T R

**SURVEY &
 REMONUMENTATION**

FEB 22 1999

SECTION


Register of Deeds Stamp & File Number

4. Lot No. _____, Recorded Plat _____

5. Private Claims _____

I, EUGENE FARRIER, in a field survey on November 4, 1998, do hereby state that under requirements of P.A. 74, Michigan P.A. of 1970, the corner points mentioned in lines 1 and 2 above were in conformance with regulations and rules therefore as required in the current manual of survey instructions of the United States Department of the Interior, Bureau of Land Management or by a decree of a Court of Law and for that the corner points mentioned in lines 3, 4 and 5 above were in conformance with the rules of the Michigan Board of Land Surveyors or by a Decree of a Court of Law; established, re-established, monumented, recovered, found as expressed below:

NOTE: Not more than 2 corners, all in the same town and range, may be recorded on this certificate.

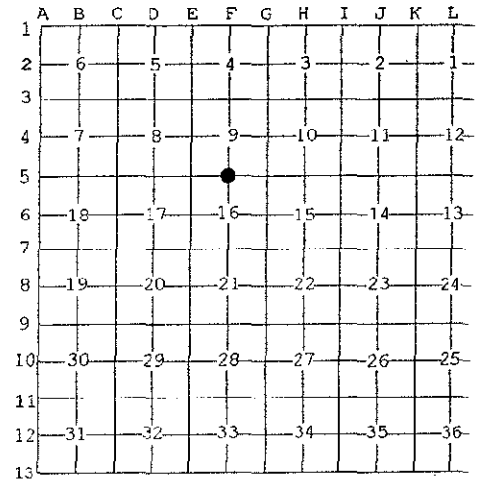

A. Description of original monument and accessories and/or subsequent restoration:

F-5: 1/4 Cor. Common to Secs. 9 & 16, T26N-R8W, Boardman Township
 1852, G.L.O. Sub. resurvey by V.W. Cankin D.S.; set corner; Hemlock 8", S53°E, 14 Lks. (9.24'); Sugar 12", N16.5°E, 66 Lks. (43.56') stream 5 Lk. C NW, East, 28.32 Chs. (1869.1')
 1902, 1907, 1908, Sec. Sub. Survey by W.S. Merrill CS., FB # 4, Pg. 68, FB # 22, Pg. 141, FB # 23, Pg. 44; shows corner only.
 9-18-78, C.F. Roser, fd. 1/2" re-rod & cap #12581 set by L. Czubak (single pro) added DNR mon. w/ cedar post, LCRC rec. in Lib. 2, Pg 124
 7-10-98, E. Farrier, Cert. of Survey, fd. DNR mon w/post

B. Description of corner evidence found and/or method applied in restoring or reestablishing corner:

F-5: 1/4 Cor. Common to Secs. 9 & 16, T26N-R8W, Boardman Township
 Fd. & accepted DNR mon w/acc. 33' South of CL 2-Track & 15' East of CL N-S trail road, (as recorded in LCRC, Liber 2, Pg. 124) left in place
 N74°W, 32.45' - 10" Tri-Maple, found nail
 N65°E, 18.84' - 18" W. Pine, found nail
 S37°E, 34.24' - 12" Maple, found nail
 S20°W, 10.47' - 14" Balsam, found nail
 No G.L.O. witnesses were found.
 Kalkaska County Peer Group accepted the above monument as a careful and faithful reestablishment of the position of the original corner

Ratified by Peer Group
P.A. 345 - 1990 Kalkaska County
 Chairman Eugene Farrier
 Date 2-2-99

C. Description of monument for corner and accessories established to perpetuate locating the position of the corner:

F-5: 1/4 Cor. Common to Secs. 9 & 16, T26N-R8W, Boardman Township
 Fd. DNR mon. w/acc. 33' South of CL 2-Track and 15' East of CL N-S Trail Road, left in place
 N74°W, 32.45' - 10" Tri-Maple, found nail
 N65°E, 18.84' - 18" W. Pine, found nail
 S37°E, 34.24' - 12" Maple, found nail
 S20°W, 10.47' - 14" Balsam, found nail



Signed by Eugene Farrier
 Michigan License No. 24594

Date 2-8-99 Surveyor's