

LAND CORNER RECORDATION CERTIFICATE
Filing Requirement of Act 74, Mich. P.A. 1970

For corners in

| | | |
|------------------------------------|--------------------------|---------------|
| <u>KALKASKA</u> | Located In: | Corner Code # |
| (County) | | |
| 1998 REMONUMENTATION | | |
| 1. Public Land Survey | T <u>26N</u> R <u>8W</u> | <u>F-9</u> |
| | T _____ R _____ | _____ |
| | T _____ R _____ | _____ |
| | T _____ R _____ | _____ |
| 2. Property Controlling in Section | S _____ T _____ R _____ | _____ |
| | S _____ T _____ R _____ | _____ |
| 3. Miscellaneous | S _____ T _____ R _____ | _____ |
| Property in Sec. | S _____ T _____ R _____ | _____ |

**SURVEY &
REMONUMENTATION**

FEB 22 1999

SECTION

Register of Deeds Stamp & File Number

4. Lot No. _____, Recorded Plat _____

5. Private Claims _____

I, EUGENE FARRIER, in a field survey on November 3, 1998 do hereby state that under requirements of P.A. 74, Michigan P.A. of 1970, the corner points mentioned in lines 1 and 2 above were in conformance with regulations and rules therefore as required in the current manual of survey instructions of the United States Department of the Interior, Bureau of Land Management or by a decree of a Court of Law and /or that the corner points mentioned in lines 3, 4 and 5 above were in conformance with the rules of the Michigan Board of Land Surveyors or by a Decree of a Court of Law; established, re-established, monumented, recovered, found as expressed below:

NOTE: Not more than 2 corners, all in the same town and range, may be recorded on this certificate.

| | | | | | | | | | | | | |
|----|----|---|----|---|----|---|----|---|----|---|----|---|
| A | B | C | D | E | F | G | H | I | J | K | L | M |
| 1 | | | | | | | | | | | | |
| 2 | 6 | | 5 | | 4 | | 3 | | 2 | | 1 | |
| 3 | | | | | | | | | | | | |
| 4 | 7 | | 8 | | 9 | | 10 | | 11 | | 12 | |
| 5 | | | | | | | | | | | | |
| 6 | 18 | | 17 | | 16 | | 15 | | 14 | | 13 | |
| 7 | | | | | | | | | | | | |
| 8 | 19 | | 20 | | 21 | | 22 | | 23 | | 24 | |
| 9 | | | | | | | | | | | | |
| 10 | 30 | | 29 | | 28 | | 27 | | 26 | | 25 | |
| 11 | | | | | | | | | | | | |
| 12 | 31 | | 32 | | 33 | | 34 | | 35 | | 36 | |
| 13 | | | | | | | | | | | | |

A. Description of original monument and accessories and/or subsequent restoration:

F-9: 1/4 Cor. Common to Secs. 21 & 28, T26N-R8W, Boardman Township
 1852, GLO. Sub. resurvey by V.W. Cankin D.S.; set corner; Hemlock 20", N45°E, 18 Lks. (11.88'); Y. Birch 10", S60°W, 17 Lks. (11.22') stream 10 Lks. C.N. East 2.49 Chs. (164.3')
 1900, Sec. Sub. Survey by W.S. Merrill CS., FB # 19, Pg. 66, found corner.
 1915, Sec. Sub. Survey by W.S. Merrill CS., Co. Survey Bk. Pg. 50; iron stake at corner.
 1948, Parcel Survey by (Unknown) Co. Survey Bk., Pg. 54; iron pipe at corner.
 9-10-79, N. Parker, shows cor. only, Lib. 2, Pg. 457, Cert. of Survey
 12-8-89, E. Farrier, fd. conc. mon. 13' W CL 2-Track to South & 30' South of CL E-W, 2-Track, 175' West of CL stream, LCRC, Lib. 2 Pg. 396
 7-23-90, E. Farrier found conc. mon, Cert. of Survey
 2-11-93, E. Farrier found 2" iron in CL of E-W rd. raised W 1/2" re-rod, Cert. of Survey (S06°W, 26.54') . con mon (recorded in LCRC as S 1/4 cor. in Lib. 2, Pg. 396)
 2-17-93, E. Farrier, fd 2" iron, raised W 1/2" iron, Lib. 4, Pg. 126, Cert. of Survey
 2-17-93, E. Farrier, fd. 2" iron, raised W 1/2" iron, LCRC, Lib. 3, Pg. 10
 7-16-96, E. Farrier, fd. 2" iron, raised W 1/2" iron, Cert. of Survey

Ratified by Peer Group
P.A. 345 - 1990 Kalkaska County
 Chairman Eugene Farrier
 Date 2-2-99

B. Description of corner evidence found and/or method applied in restoring or reestablishing corner:


F-9: 1/4 Cor. Common to Secs. 21 & 28, T26N-R8W, Boardman Township
 Fd. & accepted 2" iron, raised W 1/2" iron & cap #24594 in CL 2-Track on fence to South (as recorded in LCRC Lib. 3, Pg. 10 & prev. Cert. of Survey using same cor. as 1/4 cor.) Pulled and set 5/8" re-bar w/ aluminum cap.
 No G.L.O. witnesses were found.
 Kalkaska County Peer Group accepted the above monument as the best available evidence of the position of the original corner.

C. Description of monument for corner and accessories established to perpetuate locating the position of the corner:

F-9: 1/4 Cor. Common to Secs. 21 & 28, T26N-R8W, Boardman Township
 Fd. & accepted 2" iron, raised W 1/2" iron & cap #24594 in CL 2-Track on fence to South. Pulled and set 5/8" re-bar w/ aluminum cap.
 N25°E, 30.89' - 12" Maple, found nail
 S11°W, 60.71' - 12" Twin Maple, found nail
 S47°E, 33.99' - 10" Maple, found nail
 S06°W, 26.54', found concrete monument

Signed by Eugene Farrier
 Michigan License No. 24594

Date 2-8-99

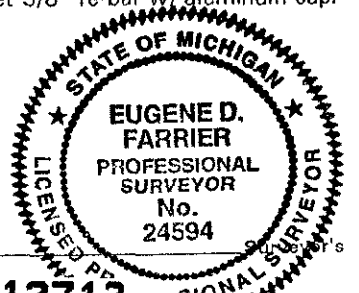

Kalkaska County REMON 9.00 LB: 5 PG: 368

3012713
 Page: 1 of 1
 02/10/1999 08:56A

REVISIONS
 JAN. 28, 1971
 REVISED MAY 14, 1976
 REVISED JAN., 1993
 REVISED OCT., 1991