

**LAND CORNER RECORDATION CERTIFICATE**  
**Filing Requirement of Act 74, Mich. P.A. 1970**

For corners in

<u>KALKASKA</u>	Located In:	Corner Code #
(County)		
1998 REMONUMENTATION		
1. Public Land Survey	T <u>26N</u> R <u>8W</u>	<u>F-11</u>
	T _____ R _____	_____
	T _____ R _____	_____
	T _____ R _____	_____
2. Property Controlling in Section	S _____ T _____ R _____	_____
	S _____ T _____ R _____	_____
3. Miscellaneous Property in Sec.	S _____ T _____ R _____	_____
	S _____ T _____ R _____	_____

**SURVEY & REMONUMENTATION**

FEB 22 1999

SECTION

Register of Deeds Stamp & File Number

4. Lot No. \_\_\_\_\_, Recorded Plat \_\_\_\_\_

5. Private Claims \_\_\_\_\_

I, EUGENE FARRIER, in a field survey on November 2, 1998 do hereby state that under requirements of P.A. 74, Michigan P.A. of 1970, the corner points mentioned in lines 1 and 2 above were in conformance with regulations and rules therefore as required in the current manual of survey instructions of the United States Department of the Interior, Bureau of Land Management or by a decree of a Court of Law and /or that the corner points mentioned in lines 3, 4 and 5 above were in conformance with the rules of the Michigan Board of Land Surveyors or by a Decree of a Court of Law; established, re-established, monumented, recovered, found as expressed below:

**NOTE: Not more than 2 corners, all in the same town and range, may be recorded on this certificate.**

A	B	C	D	E	F	G	H	I	J	K	L	N
1												
2	6		5		4		3		2		1	
3												
4	7		8		9		10		11		12	
5												
6	18		17		16		15		14		13	
7												
8	19		20		21		22		23		24	
9												
10	30		29		28		27		26		25	
11												
12	31		32		33		34		35		36	
13												

**A. Description of original monument and accessories and/or subsequent restoration:**

**F-11: 1/4 Cor. Common to Secs. 28 & 33, T26N-R8W, Boardman Township**  
 1852, GLO. Sub. resurvey by V.W. Cankin D.S.; set corner; Cedar 12", N43°W, 25 Lks. (16.50'); Cedar 14", S45°E, 21 Lks. (13.86') stream 10 Lks. C.N., West, 9.43 Chs. (622.4')  
 1882, Road Survey by E. Mosher CS., Co. Survey Bk, Pg. 36; found corner.  
 1898, 1900, Sec. Sub. Survey by E. Mosher CS., FB # 32, Pg. 82, FB # 19, Pg. 66; shows corner only.  
 1901, Sec. Sub. Survey by W.S. Merrill CS., Co. Survey Bk., Pg. 4 & 29; Cedar stake at corner located from Gov't bearing tree.  
 1915, Sec. Sub. Survey by W.S. Merrill CS., Co. Survey Bk., Pg. 50; set iron pipe at corner, between logs of crossway; old Gov't bearing tree (stump)  
 7-17-78, J. Fletcher, set 1/2" rod w/cap #19830 (M.P.O.L.) Liber 2, Pg. 214, Cert. of Survey  
 11-3-86, R. Mitchell, fd. 1" iron pipe which fits East-West distance from Merrill Survey (1901 Liber 1, Pg. 29 of Co. Surveyor records)  
 LCRC, Liber 2, Pg. 314 (removed iron & cap #19830)  
 10-6-87, E. Farrier, fd. 1/2" iron & cap, Cert. of Survey  
 11-3-87, E. Farrier, fd. 1/2" iron & cap, #28417, Cert. of Survey  
 6-5-98, E. Farrier, fd. 1/2" iron & cap, #28417, Cert. of Survey

**Ratified by Peer Group**  
**P.A. 345 - 1990 Kalkaska County**  
 Chairman Eugene Farrier  
 Date 2-2-99

**B. Description of corner evidence found and/or method applied in restoring or reestablishing corner:**


**F-11: 1/4 Cor. Common to Secs. 28 & 33, T26N-R8W, Boardman Township**  
 Fd. & accepted 1/2" iron & cap #28417, 4' North centerline road as recorded in LCRC, Liber 2, Pg. 314, and previous Cert. of Surveys)  
 Pulled & set 5/8" X 18" re-rod w/ brass cap  
 S04°E, 56.58'- 8" Tamarack  
 No G.L.O. witnesses were found  
 Kalkaska County Peer Group accepted the above monument as a careful and faithful perpetuation of the position of the original corner.

**C. Description of monument for corner and accessories established to perpetuate locating the position of the corner:**

**F-11: 1/4 Cor. Common to Secs. 28 & 33, T26N-R8W, Boardman Township**  
 Fd. & accepted 1/2" iron & cap #28417, 4' North centerline road as recorded in LCRC, Liber 2, Pg. 314, and previous Cert. of Surveys)  
 Pulled & set 5/8" X 18" re-rod w/ brass cap  
 N20°W, 29.88'- 8" Balsam, set nail & washer  
 N50°E, 34.40'- 8" Balsam, set nail & washer  
 S42°E, 78.38'-10" Tamarack, set nail & washer  
 S04°E, 56.58'- 8" Tamarack, fd. nail

Signed by Eugene Farrier  
 Michigan License No. 24594

Date 2-8-99

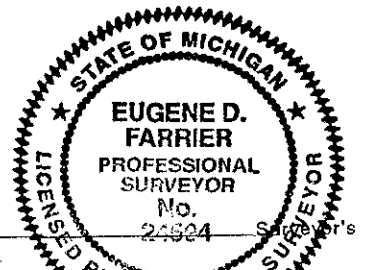

**3012714**  
 Page: 1 of 1  
 02/10/1999 08:57A  
 Kalkaska County  
 REMON  
 FEB MAY 28 1971  
 MAY 14 1975  
 REVISED JAN, 1983  
 REVISED OCT., 1996