

LAND CORNER RECORDATION CERTIFICATE
Filing Requirement of Act 74, Mich. P.A. 1970

For corners in

KALKASKA Located In: Corner Code #
 (County):
 1998 REMONUMENTATION
 1. Public Land Survey T 26N R 8W G-5
 T _____ R _____
 T _____ R _____
 T _____ R _____
 2. Property Controlling S _____ T _____ R _____
 in Section S _____ T _____ R _____
 3. Miscellaneous S _____ T _____ R _____
 Property in Sec. S _____ T _____ R _____

**SURVEY &
 REMONUMENTATION**

FEB 22 1999

SECTION


Register of Deeds Stamp & File Number

4. Lot No. _____, Recorded Plat _____

5. Private Claims _____

I, EUGENE FARRIER, in a field survey on November 4, 1998 do hereby state that under requirements of P.A. 74, Michigan P.A. of 1970, the corner points mentioned in lines 1 and 2 above were in conformance with regulations and rules therefore as required in the current manual of survey instructions of the United States Department of the Interior, Bureau of Land Management or by a decree of a Court of Law and for that the corner points mentioned in lines 3, 4 and 5 above were in conformance with the rules of the Michigan Board of Land Surveyors or by a Decree of a Court of Law; established, re-established, monumented, recovered, found as expressed below:

NOTE: Not more than 2 corners, all in the same town and range, may be recorded on this certificate.

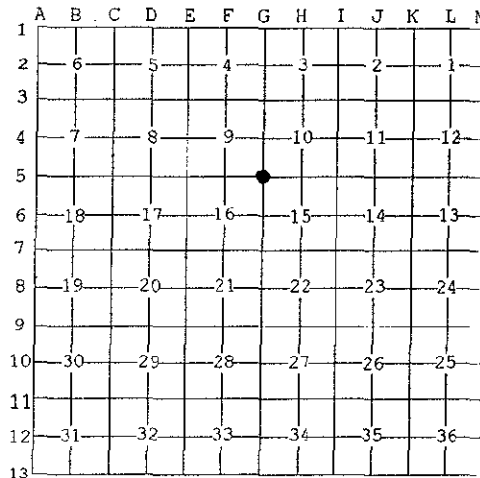

A. Description of original monument and accessories and/or subsequent restoration:

G-5: Sec. Cor. Common to Secs. 9, 10, 15 & 16, T26N-R8W, Boardman Township
 1852, GLO. Sub. resurvey by V.W. Cankin D.S.; set post at corner; Cedar 8", S33°E, 28 Lks. (18.48'); Cedar 14", N51°W, 31 Lks. (20.46') stream 3 Lks. C.W., South, 3.75 Chs. (247.5')
 1902, 1907, 1908, Sec. Sub. Survey by W.S. Merrill CS., FB # 4, Pg. 67; FB # 22, Pg. 141, Co. Survey Bk. Pg. 46; shows corner only.
 1908, Sec. Sub. Survey by W.S. Merrill CS., FB # 23, Pg. 44; found old stake and wit., marked new witness.
 1909, 1909, 1911, Sec. Sub Survey by W.S. Merrill CS., FB # 23, Pg. 129; FB # 23, Pg. 130; FB # 19, Pg. 77; shows finding corner.
 9-18-78, C.F. Roser fd. pointed stake bottom 0.5' deep in muck from remains of U.S.B.T. stumps SE & NW (Cedars) and Merrills W. Pine stump N61°E, 25.1' (still standing) & remains of his Tamarack stump NW Merrills data is in his U.S. Note Bk#19. Dated Oct. 22, 1908, set DNR mon. w/Cedar post, rec. in LCRC Lib. 2, Pg. 121.

B. Description of corner evidence found and/or method applied in restoring or reestablishing corner:

G-5: Sec. Cor. Common to Secs. 9, 10, 15 & 16, T26N-R8W, Boardman Township
 Fd. DNR mon. w/ cedar post as rec. in LCRC, Lib. 2, Pg. 121
 No G.L.O. witnesses were found.

Kalkaska County Peer Group accepted as a careful and faithful perpetuation of the position of the original corner.

**Ratified by Peer Group
 P.A. 345 - 1990 Kalkaska County**

Chairman *Eugene Farrier*

Date 2-2-99

C. Description of monument for corner and accessories established to perpetuate locating the position of the corner:

G-5: Sec. Cor. Common to Secs. 9, 10, 15 & 16, T26N-R8W, Boardman Township
 Fd. DNR mon. w/Cedar post, left in place
 S05°E, 62.23' - 12" Cedar, set nail & washer
 S70°W, 7.71' - 12" Spruce, set nail & washer
 N55°W, 44.12' - 16" Maple, set nail & washer
 N28°W, 34.28' - 14" Cedar, set nail & washer



Signed by *Eugene Farrier*
 Michigan License No. 24594

Date 2-2-99 Surveyor's



3012716
 Page: 1 of 1
 02/10/1999 09:00A