

**LAND CORNER RECORDATION CERTIFICATE**  
**Filing Requirement of Act 74, Mich. P.A. 1970**

For corners in

<u>KALKASKA</u>	Located In:	Corner Code #
(County)		
1998 REMONUMENTATION		
1. Public Land Survey	T <u>26N</u> R <u>8W</u>	<u>G-6</u>
	T _____ R _____	_____
	T _____ R _____	_____
	T _____ R _____	_____
2. Property Controlling in Section	S _____ T _____ R _____	_____
	S _____ T _____ R _____	_____
3. Miscellaneous Property in Sec.	S _____ T _____ R _____	_____
	S _____ T _____ R _____	_____

**SURVEY &  
REMONUMENTATION**

FEB 22 1999

SECTION

Register of Deeds Stamp & File Number

4. Lot No. \_\_\_\_\_, Recorded Plat \_\_\_\_\_

5. Private Claims \_\_\_\_\_

I, EUGENE FARRIER, in a field survey on November 4, 1998 do hereby state that under requirements of P.A. 74, Michigan P.A. of 1970, the corner points mentioned in lines 1 and 2 above were in conformance with regulations and rules therefore as required in the current manual of survey instructions of the United States Department of the Interior, Bureau of Land Management or by a decree of a Court of Law and/or that the corner points mentioned in lines 3, 4 and 5 above were in conformance with the rules of the Michigan Board of Land Surveyors or by a Decree of a Court of Law; established, re-established, monumented, recovered, found as expressed below:

1	A	B	C	D	E	F	G	H	I	J	K	L
2		6		5		4		3		2		1
3												
4		7		8		9		10		11		12
5												
6		18		17		16		15		14		13
7												
8		19		20		21		22		23		24
9												
10		30		29		28		27		26		25
11												
12		31		32		33		34		35		36
13												

**NOTE:** Not more than 2 corners, all in the same town and range, may be recorded on this certificate.

**A. Description of original monument and accessories and/or subsequent restoration:**

G-6: 1/4 Cor. Common to Secs. 15 & 16, T26N-R8W, Boardman Township  
1852, GLO. Sub. resurvey by V.W. Cankin D.S.; set corner; Beech 12", N50°E, 24 Lks. (15.84'); Beech 10", West, 6 Lks. (3.96') stream 3 Lks. C.W., North, 16.5 Chs. (1089.3'); stream 10 Lks. C.W., South, 16.5 Chs. (1088.7').  
1890, Road Survey by E. Mosher CS. CO. Survey Bk., Pg. 36; found corner  
1902, Sec. Sub. Survey by W.S. Merrill CS., FB # 4, Pg. 67; examined corner, found old stake & traces of one BT., set Cedar stake, buried bricks around stake.  
1907, Sec. Sub. Survey by W.S. Merrill CS., FB # 22, Pg. 16; found corner; Beech 18", N7°E, 51 Lks. (33.66'); Beech 18", S72°W, 30 Lks. (25.08')  
1909, Sec. Sub. Survey by W.S. Merrill CS., FB # 23, Pg. 130; found corner  
9-18-78, C.F. Roser fd. & accepted 5/8" re-rod w/cap #12581, LCRC rec. in Lib. 2, Pg. 120

**B. Description of corner evidence found and/or method applied in restoring or reestablishing corner:**

G-6: 1/4 Cor. Common to Secs. 15 & 16, T26N-R8W, Boardman Township  
Fd. & accepted 5/8" re-rod w/cap #12581, 47' South & 73' East of CL U.S. 131, and Cedar post as rec. in Lib. 2, Pg. 120, added aluminum cap.  
S28°E, 33.38' - 12" Maple in clump, found spike  
No G.L.D. witnesses were found.  
Kalkaska County Peer Group accepted the above monument as the best available evidence of the position of the original corner.

Ratified by Peer Group  
P.A. 345 - 1990 Kalkaska County


Chairman Eugene Farrier  
Date 2-2-99

**C. Description of monument for corner and accessories established to perpetuate locating the position of the corner:**

G-6: 1/4 Cor. Common to Secs. 15 & 16, T26N-R8W, Boardman Township  
Fd. & accepted 5/8" re-rod w/cap #12581, 47' South & 73' East of CL U.S. 131, and Cedar post as rec. in Lib. 2, Pg. 120, added aluminum cap.  
S28°E, 33.38' - 12" Maple in clump, found spike  
South 31.3' - Top of concrete r.o.w. marker  
N75°E, 404.1' - 12" W. Pine, set nail & washer  
S23°W, 50.68' - 14" Poplar, set nail & washer

Signed by Eugene Farrier  
Michigan License No. 24594

Date 2-8-99

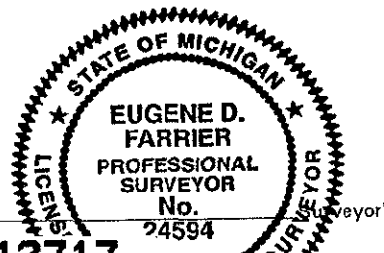

**3012717**

Page: 1 of 1

02/10/1999 09:00A

LB: 5 PG: 372

REVISIONS: JAN. 28, 1977  
REVISED MAY 14, 1978  
REVISED JAN., 1981  
REVISED OCT., 1981