

LAND CORNER RECORDATION CERTIFICATE
Filing Requirement of Act 74, Mich. P.A. 1970

For corners in

KALKASKA Located In: Corner Code #
 (County)
 1998 REMONUMENTATION
 1. Public Land Survey T.26N R.8W G-8
 T. R.
 T. R.
 T. R.
 2. Property Controlling S. T. R.
 in Section S. T. R.
 3. Miscellaneous S. T. R.
 Property in Sec. S. T. R.

**SURVEY &
 REMONUMENTATION**

FEB 22 1999

SECTION

Register of Deeds Stamp & File Number

4. Lot No. _____, Recorded Plat _____

5. Private Claims _____

I, EUGENE FARRIER, in a field survey on November 2, 1998 do hereby state that under requirements of P.A. 74, Michigan P.A. of 1970, the corner points mentioned in lines 1 and 2 above were in conformance with regulations and rules therefore as required in the current manual of survey instructions of the United States Department of the Interior, Bureau of Land Management or by a decree of a Court of Law and /or that the corner points mentioned in lines 3, 4 and 5 above were in conformance with the rules of the Michigan Board of Land Surveyors or by a Decree of a Court of Law; established, re-established, monumented, recovered, found as expressed below:

1	A	B	C	D	E	F	G	H	I	J	K	L	M
2		6		5		4		3		2		1	
3													
4		7		8		9		10		11		12	
5													
6		18		17		16		15		14		13	
7													
8		19		20		21		22		23		24	
9													
10		30		29		28		27		26		25	
11													
12		31		32		33		34		35		36	
13													

NOTE: Not more than 2 corners, all in the same town and range, may be recorded on this certificate.

A. Description of original monument and accessories and/or subsequent restoration:

G-8: 1/4 Cor. Common to Secs. 21 & 22, T26N-R8W, Boardman Township
 1852, GLO. Sub. resurvey by V.W. Cankin D.S.; set corner; Beech 12", S25°E, 20 Lks. (13.20'); Beech 8", N81°W, 35 Lks. (23.10')
 1882, Road Survey by E. Mosher CS., Co. Survey Bk. Pg. 36, found corner
 1948, Parcel Survey by (Unknown) Co. Survey Bk. Pg. 54; shows corner only.
 12-8-89, E. Farrier, set 1/2" iron & cap #24594, by re-establishing local evidence, see LCRC, Lib. 2, Pg. 396
 7-23-90, E. Farrier, shows cor. only, Cert. of Survey
 12-11-90, E. Farrier, fd. iron & cap #24594, Cert. of Survey
 2-17-93, E. Farrier, fd. iron & cap #24594, Cert. of Survey
 5-18-93, E. Farrier, fd. iron & cap #24594, Cert. of Survey
 6-21-95, E. Farrier, fd. iron & cap #24594, Cert. of Survey
 5-15-96, E. Farrier, fd. iron & cap #24594, Cert. of Survey

B. Description of corner evidence found and/or method applied in restoring or reestablishing corner:

G-8: 1/4 Cor. Common to Secs. 21 & 22, T26N-R8W, Boardman Township
 Fd. & accepted iron & cap #24594 in CL N-S 2-Track & 22' West of old down N-S fence (as rec. in LCRC, Lib. 2, Pg. 396 & prev. Cert. of Surveys) Pulled and set 5/8" X 18" re-bar w/brass cap
 No G.L.O. witnesses were found.
 Kalkaska County Peer Group accepted the above monument as a careful and faithful reestablishment of the position of the original corner.

**Ratified by Peer Group
 P.A. 345 - 1990 Kalkaska County**

Chairman Eugene Farrier


Date 2-2-99

C. Description of monument for corner and accessories established to perpetuate locating the position of the corner:

G-8: 1/4 Cor. Common to Secs. 21 & 22, T26N-R8W, Boardman Township
 Fd. & accepted iron & cap #24594 in CL North-South 2-Track & 22' West of old down N-S fence. Pulled and set 5/8" X 18" re-bar w/brass cap
 N58°W, 45.94' - 10" Twjn Birch, set nail & washer
 N53°E, 28.79' - 18" Maple, set nail & washer
 S55°E, 63.53' - 12" R. Pine, set nail & washer
 S82°W, 32.01' - 14" Maple, set nail & washer

Signed by Eugene Farrier
 Michigan License No. 24594

Date 2-8-99

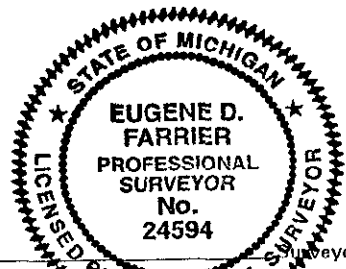

Kalkaska County

REMON

9.00

3012719

Page: 1 of 1

02/10/1999 09:02A

LB: 5 PG: 374

PROFESSIONAL SURVEYOR'S
 REVISORS, JAN. 28, 197
 REVISED MAY 14, 1971
 REVISED JAN., 1987
 REVISED OCT., 1993