

LAND CORNER RECORDATION CERTIFICATE
Filing Requirement of Act 74, Mich. P.A. 1970

For corners in

<u>KALKASKA</u>	Located In:	Corner Code #
(County)		
1998 REMONUMENTATION		
1. Public Land Survey	T <u>26N</u> R <u>8W</u>	<u>G-10</u>
	T _____ R _____	_____
	T _____ R _____	_____
	T _____ R _____	_____
2. Property Controlling	S _____ T _____ R _____	_____
in Section	S _____ T _____ R _____	_____
3. Miscellaneous	S _____ T _____ R _____	_____
Property in Sec.	S _____ T _____ R _____	_____

**SURVEY &
REMONUMENTATION**

FEB 22 1999

SECTION

Register of Deeds Stamp & File Number

4. Lot No. _____, Recorded Plat _____

5. Private Claims _____

I, EUGENE FARRIER, in a field survey on November 2, 1998 do hereby state that under requirements of P.A. 74, Michigan P.A. of 1970, the corner points mentioned in lines 1 and 2 above were in conformance with regulations and rules therefore as required in the current manual of survey instructions of the United States Department of the Interior, Bureau of Land Management or by a decree of a Court of Law and for that the corner points mentioned in lines 3, 4 and 5 above were in conformance with the rules of the Michigan Board of Land Surveyors or by a Decree of a Court of Law; established, re-established, monumented, recovered, found as expressed below:

1	A	B	C	D	E	F	G	H	I	J	K	L
2		6		5		4		3		2		1
3												
4		7		8		9		10		11		12
5												
6		18		17		16		15		14		13
7												
8		19		20		21		22		23		24
9												
10		30		29		28		27		26		25
11												
12		31		32		33		34		35		36
13												

NOTE: Not more than 2 corners, all in the same town and range, may be recorded on this certificate.

A. Description of original monument and accessories and/or subsequent restoration:

G-10: 1/4 Cor. Common to Secs. 27 & 28, T26N-R8W, Boardman Township
1852, GLO. Sub. resurvey by V.W. Cankin D.S.; set corner; Sugar 18", S22°W, 14 Lks. (9.24'); Beech 7", N26°E, 17 Lks. (11.22')
1882, Road Survey by E. Mosher CS. Co. Survey Bk. Pg. 36; found corner.
1900, 1902, 1915, Sec. Sub. Survey by W.S. Merrill CS., FB # 19, Pg. 66, Co. Survey Bk. Pg. 12, 59 & 50; shows corner only.
9-13-74, L. Czubak set iron & cap, Liber 1, Pg. 582, Cert. of Survey, S.P. to Mosher (7-31-1882)
10-30-74, L. Czubak, set iron & cap form Mosher notes 7-34-1882, LCRC, Liber 1, Pg. 329
8-21-79, J. Wilcox, fd. iron Liber 2, Pg. 517, Cert. of Survey
10-6-87, E. Farrier, fd. 1/2" iron & cap, Cert. of Survey
11-3-87, E. Farrier, fd. 1/2" iron & cap, Cert. of Survey
6-15-95, P. Case, shows cor. only, Liber 4, Pg. 307, Cert. of Survey
12-24-96, E. Farrier, fd. 1/2" iron, Cert. of Survey
10-7-97, E. Farrier, fd. 1/2" iron, Cert. of Survey
7-16-98, E. Farrier, fd. 1/2" iron, Cert. of Survey

B. Description of corner evidence found and/or method applied in restoring or reestablishing corner:

G-10: 1/4 Cor. Common to Secs. 27 & 28, T26N-R8W, Boardman Township
Fd. and accepted 5/8" re-rod, 4' West of centerline of road & 4' South of Centerline Trail Road to NW (as recorded in LCRC, Liber 1, Pg. 329 & prev. Cert. of Surveys) Added brass cap (standard Co. Mon.)
N36°W, 52.68'- 8" R. Pine, fd. nail
No G.L.O. witnesses were found
Kalkaska County Peer Group accepted the above monument as a careful and faithful reestablishment of the position of the original corner

Ratified by Peer Group
P.A. 345 - 1990 Kalkaska County
Chairman Eugene Farrier
Date 2-2-99

C. Description of monument for corner and accessories established to perpetuate locating the position of the corner:

G-10: 1/4 Cor. Common to Secs. 27 & 28, T26N-R8W, Boardman Township
Fd. and accepted 5/8" re-rod, 4' West of centerline of road & 4' South of Centerline Trail Road to NW (as recorded in LCRC, Liber 1, Pg. 329 & prev. Cert. of Surveys), added brass cap
N65°E, 29.17'- 16" Maple, set nail
S75°E, 34.73'- 22" maple, set nail
West, 33.00'- iron & cap #26450
N36°W, 52.68' - 8" R. Pine, found nail

Signed by Eugene Farrier
Michigan License No. 24594

Date 2-8-99




3012721

Page: 1 of 1

02/10/1999 09:03A

LB: 5 PG: 376

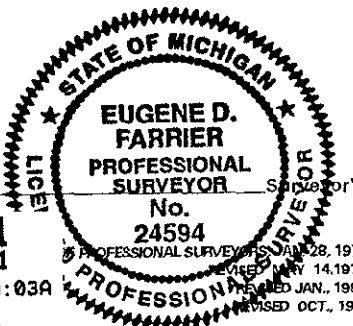

PROFESSIONAL SURVEYOR'S ACT, 1977
REVISED JAN. 1997
REVISED OCT., 1998